

007938

LIBER 3 PAGE 251

RECORDED  
HILLSDALE CO. MICH.

'98 AUG 7 AM 10 10

ACCEPTED BY THE HILLSDALE COUNTY SURVEY PEER GROUP AS THE OFFICIAL CORNER UNDER MICHIGAN PUBLIC ACT 345 OF 1990 AT A MEETING HELD ON \_\_\_\_\_  
AL RINGENBERG, CD. REP.

**HILLSDALE COUNTY REMONUMATION CORNER  
LAND CORNER RECORDATION CERTIFICATE**  
Filing Requirement of Act 74, Mich. P.A. 1970

For corners in

HILLSDALE COUNTY  
ADAMS TOWNSHIP

Located In: Corner Code #

- 1. Public Land Survey T 6 S R 2 W D-7  
T \_\_\_\_\_ R \_\_\_\_\_  
T \_\_\_\_\_ R \_\_\_\_\_  
T \_\_\_\_\_ R \_\_\_\_\_
- 2. Property Controlling in Section S \_\_\_\_\_ T \_\_\_\_\_ R \_\_\_\_\_  
S \_\_\_\_\_  
T \_\_\_\_\_ R \_\_\_\_\_
- 3. Miscellaneous S \_\_\_\_\_ T \_\_\_\_\_ R \_\_\_\_\_  
Property in Sec. S \_\_\_\_\_ T \_\_\_\_\_ R \_\_\_\_\_

**SURVEY &  
REMONUMENTATION**

**FEB 23 1999**

*Judy VanZandt*  
REC. OF DEEDS

Register of Deeds Stamp & File Number

- 4. Lot No. \_\_\_\_\_, Recorded Plat \_\_\_\_\_ SECTION \_\_\_\_\_
- 5. Private Claims \_\_\_\_\_

	A	B	C	D	E	F	G	H	I	J	K	L	M
1													
2	6		5		4		3		2		1		
3													
4	7		8		9		10		11		12		
5													
6	18		17		16		15		14		13		
7													
8	19		20		21		22		23		24		
9													
10	30		29		28		27		26		25		
11													
12	31		32		33		34		35		36		
13													

I, EDWARD W. REED, in a field survey on JUNE 26, 1998 do hereby state that under requirements of P.A. 74, Michigan P.A. of 1970, the corner points mentioned in lines 1 and 2 above were in conformance with regulations and rules therefore as required in the current manual of survey instructions of the United States Department of the Interior, Bureau of Land Management or by a decree of a Court of Law and /or that the corner points mentioned in lines 3, 4 and 5 above were in conformance with the rules of the Michigan Board of Land Surveyors or by a Decree of a Court of Law; established, re-established, monumented, recovered, found as expressed below:

**NOTE: Not more than 2 corners, all in the same town and range, may be recorded on this certificate.**

**QUARTER CORNER COMMON TO SECTIONS 17 & 20**

A. Description of original monument and accessories and/or subsequent restoration:

- 1825: ROBERT CLARK JR. DEPT SURVEYOR - CORNER SET
- 1868: GEO. A. MARK, COUNTY SURVEYOR, - SURVEY # 476 STONE AND BRICK
- 1878: GEO. A. MARK, COUNTY SURVEYOR - STONE & BRICK, 12" ELM
- 1987: BRUCE LEONE, SURVEYOR- FOUND POINTED STONE CIRCLED WITH BROKEN BRICK 4 1/2' BELOW ROAD SURFACE, ALSO FOUND 1" PIPE 4 1/2' WEST AND 2 1/2' NORTH OF STONE LOCATION, SET 4" DIA HARRISON MARKER AT STONE LOCATION, RECORDED IN LCRC LIBER 573, PAGE 132

B. Description of corner evidence found and/or method applied in restoring or reestablishing corner:


FOUND HARRISON MARKER AS DESCRIBED IN LCRC LIBER 573, PAGE 132

C. Description of monument for corner and accessories established to perpetuate locating the position of the corner:

SET 3/4" X 30" REBAR IRON WITH REMON CAP IN CI-MONUMENT BOX

- PK NAIL 2' UP N.E. SIDE OF 18" CHINESE ELM N 46 W 94.53'
- CHISELED CROSS ON 3' X 2' FLAT ROCK (FLUSH WITH GROUND) N 18 W 51.06'
- PK NAIL 4 1/2' UP N.W. SIDE OF 20" WILLOW N 58 E 64.15'
- SOUTH EDGE OF TEL PEDESTAL NORTH 34.70'
- NE CORNER TEL PEDESTAL S 85 W 162.22'

AND IS ACCEPTED AS A CAREFUL AND FAITHFUL PERPETUATION OF THE POSITION OF THE ORIGINAL CORNER

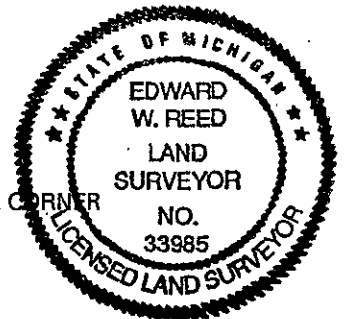

Signed by Edward W. Reed Date AUGUST 5, 1998

EDWARD W. REED

Surveyor's Michigan License No. 33985