



10492

LIBER 3 PAGE 266

RECORDED HILLSDALE CO. MICH.

'98 OCT 15 PM 1 17

HILLSDALE COUNTY REMONUMENTATION CORNER LAND CORNER RECORDATION CERTIFICATE Filing Requirement of Act 74, Mich. P.A. 1970

Julie VanZandt REG. OF DEEDS

For corners in

HILLSDALE COUNTY ADAMS TWP (County)

Located in: Corner Code #

1. Public Land Survey T 6 S R 2 W F-7
2. Property Controlling in Section S T R SURVEY & REMONUMENTATION
3. Miscellaneous Property in Sec. S T R
FEB 23 1999

Register of Deeds Stamp & File Number

4. Lot No. , Recorded Plat SECTION

5. Private Claims

I, EDWARD W. REED, in a field survey on JULY 26, 1998 do hereby state that under requirements of P.A. 74, Michigan P.A. of 1970, the corner points mentioned in lines 1 and 2 above were in conformance with regulations and rules therefore as required in the current manual of survey instructions of the United States Department of the Interior, Bureau of Land Management or by a decree of a Court of Law and /or that the corner points mentioned in lines 3, 4 and 5 above were in conformance with the rules of the Michigan Board of Land Surveyors or by a Decree of a Court of Law; established, re-established, monumented, recovered, found as expressed below:

Grid table with columns A-L and rows 1-13. A dot is marked at row 7, column F.

NOTE: Not more than 2 corners, all in the same town and range, may be recorded on this certificate.

QUARTER CORNER COMMON TO SECTIONS 16 & 21

A. Description of original monument and accessories and/or subsequent restoration:

- 1825: GOVERNMENT SURVEY, CORNER SET
1853: MANROSS, CO. SURVEYOR, POST FOR CORNER
1872: GEO. MARK, CO SURVEYOR, SET 24" STONE FOR CORNER, SURVEY # 670
1874: RANSON BULLARD, CO SURVEYOR, STONE & BRICK, SURVEY # 686
1980: ALAN RINGENBERG, SURVEYOR, RESET CORNER FROM OLD NOTES, NO EVIDENCE OF CORNER, RECORDED IN LCRC LIBER 2, PAGE 16
1987: B. LEONE, SURVEYOR, FOUND BOTTOM HALF OF STONE CIRCLED WITH BROKEN BRICK, 4' SOUTH AND 1' EAST OF RINGENBURGS IRON: SET 4" DIA. HARRISON MONUMENT, RECORDED IN LCRC LIBER 573, PAGE 134


B. Description of corner evidence found and/or method applied in restoring or reestablishing corner:

FOUND BOTTOM HALF OF BROKEN STONE, AND BRICK SURROUNDING HARRISON MONUMENT AS DESCRIBED BY LEONE IN LIBER 573/134

C. Description of monument for corner and accessories established to perpetuate locating the position of the corner:

REPLACE HARRISON MARKER WITH 3/4" X 30" REBAR IRON WITH REMON CAP IN CI-MONUMENT BOX SET 5" BELOW GRAVEL ROAD GRADE

PK NAIL 24" UP EAST SIDE OF (EASTERLY) 8" TWIN HICKORY N 4 E 79.57'
PK NAIL 36" UP SW SIDE OF (EASTERLY) 15" TWIN HICKORY N 65 W 64.65'
PK NAIL IN TOP OF 3RD SOUTHERLY POST OF BRIDGE RAIL FROM EAST END OF BRIDGE S 89 W 181.88'
PK NAIL 5' UP NORTH SIDE OF 6" OAK S 79 W 105.14'
IRON ROD SET BY RINGENBERG NORTH 4' WEST 1'

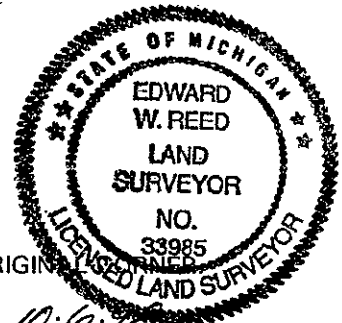

AND IS ACCEPTED AS A CAREFUL AND FAITHFUL PERPETUATION OF THE POSITION OF THE ORIGINAL CORNER

Signed by [signature]

Date 10-6-98

Surveyor's Michigan License No. 33985

EDWARD R. REED