

007933

RECORDED

HILLSDALE CO. MICH.

'98 AUG 7 AM 10 09



LIBER 3 PAGE 246

HILLSDALE COUNTY REMONUMENTATION CORNER  
LAND CORNER RECORDATION CERTIFICATE  
Filing Requirement of Act 74, Mich. P.A. 1970

For corners in

HILLSDALE COUNTY  
ADAMS TOWNSHIP

Located in: Corner Code #

*Judy VanZandt*  
REG. OF DEEDS

- 1. Public Land Survey T 6 S R 2 W H-1
- T      R
- T      R
- T      R
- 2. Property Controlling in Section S      T      R
- S
- T      R
- 3. Miscellaneous S
- T      R
- Property in Sec. S
- T      R

SURVEY &  
REMONUMENTATION

FEB 23 1999

SECTION Register of Deeds Stamp & File Number

4. Lot No. \_\_\_\_\_, Recorded Plat \_\_\_\_\_

5. Private Claims \_\_\_\_\_

I, EDWARD W. REED, in a field survey on JULY 26, 1998 do hereby state that under requirements of P.A. 74, Michigan P.A. of 1970, the corner points mentioned in lines 1 and 2 above were in conformance with regulations and rules therefore as required in the current manual of survey instructions of the United States Department of the Interior, Bureau of Land Management or by a decree of a Court of Law and /or that the corner points mentioned in lines 3, 4 and 5 above were in conformance with the rules of the Michigan Board of Land Surveyors or by a Decree of a Court of Law; established, re-established, monumented, recovered, found as expressed below:

NOTE: Not more than 2 corners, all in the same town and range, may be recorded on this certificate

1	A	B	C	D	E	F	G	H	I	J	K	L	M
2	6		5		4		3		2		1		
3													
4	7		8		9		10		11		12		
5													
6	18		17		16		15		14		13		
7													
8	19		20		21		22		23		24		
9													
10	30		29		28		27		26		25		
11													
12	31		32		33		34		35		36		
13													

NORTH QUARTER CORNER TO SECTION 3

A. Description of original monument and accessories and/or subsequent restoration:

1881: GEO. MARK, SURVEYOR - STONE  
1992: FRED CUTCHER, SURVEYOR - CORNER DUG FOR BY HILLSDALE COUNTY ROAD COMMISSION ON JULY 23, 1991, FOUND "T" IRON WITH 1/2 IRON ROD WITH "L" TOP IN HOLLOW CLAY TILE. SET HARRISON MARKER OVER TILE AND IRON, RECORDED IN LCRC LIBER 671, PAGE 729

B. Description of corner evidence found and/or method applied in restoring or reestablishing corner:


FOUND HARRISON MARKER AS DESCRIBED IN LIBER 671, PAGE 729

C. Description of monument for corner and accessories established to perpetuate locating the position of the corner:

REPLACE HARRISON MARKER WITH 3/4" x 30" REBAR IRON WITH REMON CAP IN CI-MONUMENT BOX FLUSH WITH PAVED ROAD SURFACE

CENTER OF 8" MAPLE S.W. 104.9'  
3.8' E. OF CENTERLINE OF ROAD (AS MARKED)  
N.E. CORNER OF HOUSE S.W. 115.15' (TO BRICK)  
PK NAIL IN N. SIDE OF R.R. TIE S.E. 50.52' (S.'LY TIE)  
TOP CENTER OF TEL. STAN. N.W. 78.45'

AND IS ACCEPTED AS THE BEST AVAILABLE EVIDENCE OF THE POSITION OF THE ORIGINAL CORNER.

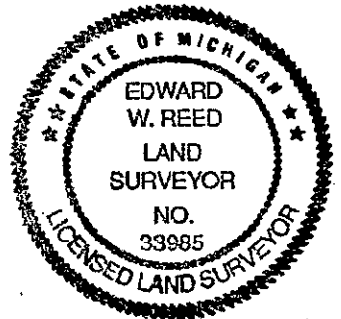

Signed by *Edward W. Reed*  
EDWARD W. REED

Date AUGUST 5, 1998

Surveyor's Michigan License No. 33985