

007935

RECORDED

HILLSDALE CO. MICH.

98 AUG 7 AM 10 09

LIBER 3 PAGE 248

HILLSDALE COUNTY REMONUMATION CORNER
LAND CORNER RECORDATION CERTIFICATE
Filing Requirement of Act 74, Mich. P.A. 1970

APPROVED BY THE HILLSDALE COUNTY
SURVEYOR PEER GROUP AS THE OFFICIAL
CORNER UNDER MICHIGAN PUBLIC ACT 345
OF 1937 AT MEETING HELD ON
8-5-98
AL RINGENBERG, CO. REP.

For corners in

HILLSDALE COUNTY
ADAMS TWP.

Located In:

Corner Code

Judy VanZandt
REG. OF DEEDS

- 1. Public Land Survey T 6 S R 2 W H-5
T _____ R _____
T _____ R _____
T _____ R _____
- 2. Property Controlling S _____ T _____ R _____
in Section S _____
T _____ R _____
- 3. Miscellaneous S _____
T _____ R _____
Property in Sec. S _____
T _____ R _____

SURVEY &
REMONUMENTATION

Register of Deeds Stamp & File Number

FEB 23 1999

SECTION

- 4. Lot No. _____, Recorded Plat _____
- 5. Private Claims _____

	A	B	C	D	E	F	G	H	I	J	K	L	M
1													
2		6		5		4		3		2		1	
3													
4		7		8		9		10		11		12	
5								●					
6		18		17		16		15		14		13	
7													
8		19		20		21		22		23		24	
9													
10		30		29		28		27		26		25	
11													
12		31		32		33		34		35		36	
13													

I, EDWARD W. REED, in a field survey on AUGUST 4, 19 98
do hereby state that under requirements of P.A. 74, Michigan P.A. of 1970, the corner points
mentioned in lines 1 and 2 above were in conformance with regulations and rules therefore as
required in the current manual of survey instructions of the United States Department of the
Interior, Bureau of Land Management or by a decree of a Court of Law and /or that the corner
points mentioned in lines 3, 4 and 5 above were in conformance with the rules of the Michigan
Board of Land Surveyors or by a Decree of a Court of Law; established, re-established,
monumented, recovered, found as expressed below:

NOTE: Not more than 2 corners, all in the same town and range, may be recorded
on this certificate.

QUARTER CORNER COMMON TO SECTIONS 10 & 15

A. Description of original monument and accessories and/or subsequent restoration:

1973: A. JOHN HATT, SURVEYOR; RESET CORNER BY PRORATED DISTANCES: SET RR RAIL SPIKE, RECORDED IN LCRC LIBER 1,
PAGE 317


B. Description of corner evidence found and/or method applied in restoring or reestablishing corner:

FOUND RR SPIKE AS DESCRIBED IN LIBER 1, PAGE 317

C. Description of monument for corner and accessories established to perpetuate locating the position of the corner:

SET 3/4" X 30 REBAR IRON WITH REMON CAP IN PLACE OF RR SPIKE, IN CI-MONUMENT BOX FLUSH WITH PAVED ROAD
SURFACE

- PK NAIL IN N SIDE OF 18" MAPLE S 70 W 59.03'
- PK NAIL IN S SIDE OF 20" MAPLE N 75 E 99.01
- SW CORNER HOUSE (NOT PORCH) N 35 E 110.08'
- NAIL & WASHER IN W. SIDE POWER POLE S 15 E 89.15'
- NAIL & WASHER IN E. SIDE POWER POLE N 14 W 121.00'
- NE COR. TEL PED. S 40 W 46.52'

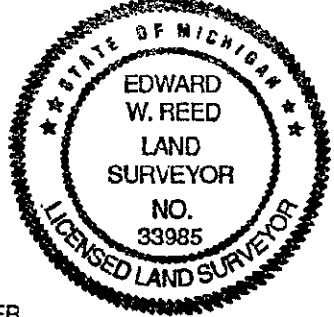

AND IS ACCEPTED AS THE BEST AVAILABLE EVIDENCE OF THE POSITION OF THE ORIGINAL CORNER.

Signed by *Edward W. Reed*
EDWARD W. REED

Date AUGUST 5, 1998

Surveyor's Michigan License No. 33985