007944

ACCEPTED BY THE HILLSDALE COUNTY SURVEY PEER GROUP AS THE OFFICIAL CORNER UNDER MICHIGAN PUBLIC ACT 345 OF 1990 AT A MEETING HELD ON
AL RINGENBERG, CO. REP.

LIBER 3 PAGE 257

RECORDED
HILLSDALE CO. MICH.
'98 AUG 7 AM 10 10
Judy VanZandt
REG. OF DEEDS

HILLSDALE COUNTY REMONUMATION CORNER LAND CORNER RECORDATION CERTIFICATE

Filing Requirement of Act 74, Mich. P.A. 1970

For corners in

HILLSDALE COUNTY
ADAMS TWP.

		Located In:	Corner Code #
1. Public Land Survey		T 6 S R 2 W	L-7
		T___ R___	
		T___ R___	
		T___ R___	
2. Property Controlling in Section	S___	T___ R___	
	S___		
	T___	R___	
3. Miscellaneous	S___		
	T___	R___	
Property in Sec.	S___		
	T___	R___	

SURVEY & REMONUMENTATION
FEB 23 1999
SECTION

Register of Deeds Stamp & File Number

4. Lot No. _____, Recorded Plat _____
5. Private Claims _____

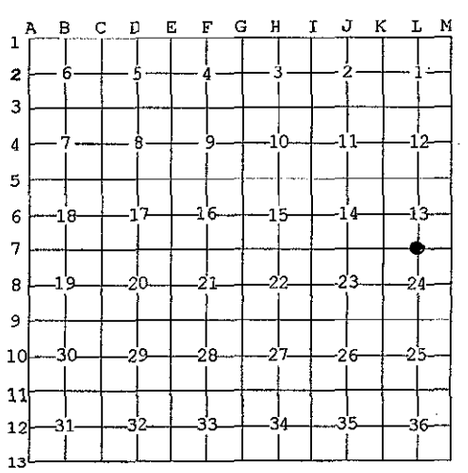

I, EDWARD W. REED, in a field survey on JULY 2, 19 98 do hereby state that under requirements of P.A. 74, Michigan P.A. of 1970, the corner points mentioned in lines 1 and 2 above were in conformance with regulations and rules therefore as required in the current manual of survey instructions of the United States Department of the Interior, Bureau of Land Management or by a decree of a Court of Law and /or that the corner points mentioned in lines 3, 4 and 5 above were in conformance with the rules of the Michigan Board of Land Surveyors or by a Decree of a Court of Law; established, re-established, monumented, recovered, found as expressed below:

NOTE: Not more than 2 corners, all in the same town and range, may be recorded on this certificate.

QUARTER CORNER COMMON TO SECTIONS 13 & 24

A. Description of original monument and accessories and/or subsequent restoration:

1893: GEO. A. MARK, SURVEYOR: FOUND STONE AND BRICK, SURVEY RECORDED IN BOOK VIII, PAGE 133, IN RECORDS OF SURVEY
1972: A. JOHN HATT, SURVEYOR: FOUND STONE AND BRICK 6" BELOW GRAVEL ROAD SURFACE, AND SET ½" IRON PIPE IN SOUTH SIDE OF STONE, RECORDED IN LCRC LIBER 1, PAGE 89, HILLSDALE COUNTY REGISTER OF DEEDS.

B. Description of corner evidence found and/or method applied in restoring or reestablishing corner:

FOUND PINCHED PIPE AND 3' X 3' STONE

C. Description of monument for corner and accessories established to perpetuate locating the position of the corner:

REMOVED PIPE AND STONE; SET 3/4" X 30" REBAR IRON ROD WITH REMON CAP AT LOCATION OF STONE; SET CI-MONUMENT BOX OVER IRON 4" BELOW GRAVEL ROAD SURFACE.

NAIL WITH ID WASHER, EAST SIDE OF 20" BLACK WALNUT	N 8 W	17.28'
NAIL WITH ID WASHER, SE SIDE OF 12" BLACK WALNUT	N 80 W	126.65'
10" WALNUT	SOUTH	59.8'
6" APPLE TREE	S 21 E	80.91
12" WALNUT	N 85 E	127.5

STATE OF MICHIGAN
EDWARD W. REED
LAND SURVEYOR
NO. 33985
LICENSED LAND SURVEYOR

AND IS ACCEPTED AS A CAREFUL AND FAITHFUL PERPETUATION OF THE POSITION OF THE ORIGINAL CORNER

Signed by Edward W Reed — Date AUGUST 5, 1998

EDWARD W. REED

Surveyor's Michigan License No. 33985

FORM APPROVED BY MICHIGAN STATE BOARD OF PROFESSIONAL SURVEYORS, JAN. 28, 197
REVISED MAY 14,197
REVISED JAN., 198
REVISED OCT., 199