



HILLSDALE COUNTY REMONUMENTATION CORNER LAND CORNER RECORDATION CERTIFICATE Filing Requirement of Act 74, Mich. P.A. 1970

For corners in

HILLSDALE COUNTY ADAMS TWP (County)

Located In:

Corner Code #

- 1. Public Land Survey T 6 S R 2 W M-7
2. Property Controlling in Section S T R SURVEY & REMONUMENTATION
3. Miscellaneous Property in Sec. S T R FEB 23 1999

Judy VanZandt REG. OF DEEDS

Register of Deeds Stamp & File Number

4. Lot No. , Recorded Plat SECTION
5. Private Claims

Grid table with columns A-L and rows 1-13. Contains numbers 1-36 in a grid pattern.

I, EDWARD W. REED, in a field survey on AUGUST 13, 1998 do hereby state that under requirements of P.A. 74, Michigan P.A. of 1970, the corner points mentioned in lines 1 and 2 above were in conformance with regulations and rules therefore as required in the current manual of survey instructions of the United States Department of the Interior, Bureau of Land Management or by a decree of a Court of Law and /or that the corner points mentioned in lines 3, 4 and 5 above were in conformance with the rules of the Michigan Board of Land Surveyors or by a Decree of a Court of Law; established, re-established, monumented, recovered, found as expressed below:

NOTE: Not more than 2 corners, all in the same town and range, may be recorded on this certificate.

SE CORNER SECTION 13, NE CORNER SECTION 24

A. Description of original monument and accessories and/or subsequent restoration:

1825: GOVERNMENT SURVEY TO SET CORNER
1893: SURVEY, STONE
NO OTHER SURVEYS OF THIS CORNER


B. Description of corner evidence found and/or method applied in restoring or reestablishing corner:

DUG 10' X 10' X 5' HOLE, UNABLE TO FIND EVIDENCE OF OLD CORNER
RESET CORNER DOUBLE PROPORTIONATE DISTANCE NORTH AND WEST

C. Description of monument for corner and accessories established to perpetuate locating the position of the corner:

SET 3/4" X 30" REBAR IRON WITH REMON CAP IN CI-MONUMENT BOX 5" BELOW GRAVEL ROAD SURFACE

- WOOD RR RAIL POST, N 20 E 32.26'
NW COR. TEL PED S 70 E 48.14'
SPIKE & WASHER E. SIDE 18" OAK S 40 E 67.64'
SPIKE & WASHER W. SIDE 12" TWIN ELM N 40 E 67.64'
SPIKE & WASHER E. SIDE 12" TWIN ELM N 40 W 173.75'
OLD REMAINS OF FENCE RUNNING EAST NORTH 12 LINKS (GLO NOTES)

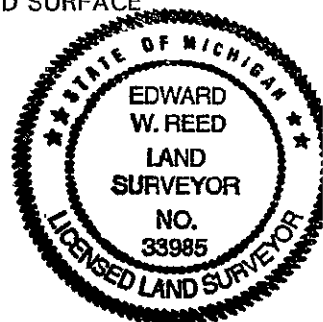

AND IS ACCEPTED AS THE BEST AVAILABLE EVIDENCE OF THE POSITION OF THE ORIGINAL CORNER.

Signed by [Signature] EDWARD R. REED
Surveyor's Michigan License No. 33985

Date 10.6.98