



12023

RECORDED HILLSDALE CO. MICH.

LIBER 3 PAGE 282

HILLSDALE COUNTY REMONUMENTATION LAND CORNER RECORDATION CERTIFICATE Filing Requirement of Act 74, Mich. P.A. 1970

'98 NOV 25 AM 10 02

Judy VanZandt REC'D DEEDS

For corners in

Hillsdale (County)

Located In: Corner Code #

- 1. Public Land Survey T 6S R 3W A-9
2. Property Controlling in Section S T R
3. Miscellaneous Property in Sec. S T R

SURVEY & REMONUMENTATION

FEB 23 1999

SECTION

Register of Deeds Stamp & File Number

- 4. Lot No. Recorded Plat
5. Private Claims

Grid table with columns A-M and rows 1-13. Contains numbers 1-36 in a grid pattern.

I, Frederick J. Cutcher, in a field survey on October 24, 1998 do hereby state that under requirements of P.A. 74, Michigan P.A. of 1970, the corner points mentioned in lines 1 and 2 above were in conformance with regulations and rules therefore as required in the current manual of survey instructions of the United States Department of the Interior, Bureau of Land Management or by a decree of a Court of Law and/or that the corner points mentioned in lines 3, 4 and 5 above were in conformance with the rules of the Michigan Board of Land Surveyors or by a Decree of a Court of Law; established, re-established, monumented, recovered, found as expressed below:

NOTE: Not more than 2 corners, all in the same town and range, may be recorded on this certificate.

A. Description of original monument and accessories and/or subsequent restoration:

G.L.O. by Robt. Clark, Jr., 4/28/1825: White Oak 11" S. 21-1/2° W. 51-1/2 lks; White Oak 13" N 88° E. 32 lks.

Survey No. 1618, Book X, Page 183, Clark Herron, 11/30/1928: Found stone & earthen from witness trees; Maple 15' N. 80° 50' E. 18.2'; Maple 30" S. 74° 30' W. 39.2'.

LCRC 5779, Robert E. Burris, Sr., 11/28/73: Found 16 penny nail; P.K. Nail N.W. side 18" Wild Cherry N. 20° W. 53.92'; P.K. Nail S. side 30" Wild Cherry (dead) S. 65° E. 25.10'; P.K. Nail S.W. side 36" Oak, S. 35° E. 62.15'.


B. Description of corner evidence found and/or method applied in restoring or reestablishing corner:

Hillsdale County Road Commission is in the process of reworking this intersection. On 9/8/98 from the one remaining reference (36" oak S. 35° E. 62.15') of Burris, searched for 16 penny nail before asphalt was removed by Road Commission. Nail is gone. On 9/9/98 Road Commission dug for corner and found stone and crockery 5' below road surface.

C. Description of monument for corner and accessories established to perpetuate locating the position of the corner:

On 10/24/98 set 3/4" x 30" iron with remonumentation cap in monument box over stone found and is accepted as the best available evidence of the position of the original corner.

4' East of centerline of N/S road, 37.62' North of corner common to Sections 24 & 25, T6S, R4W, Allen Twp. Set nail & spotter N.E. side Pwr. pole N. 35° W. 76.0' Set nail & spotter S. side 10" Maple East 24.54' Set nail & spotter S.W. side 36" Oak S. 23° E. 64.85' Set nail & spotter W. side 12" Maple S. 11° E. 86.90' In line with fence posts to East

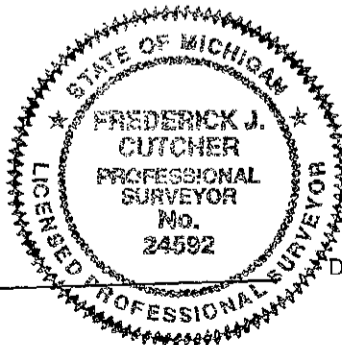

Signed by Frederick J. Cutcher

Date 11/4/98

Surveyor's Michigan License No. 24592