

# SURVEY & REMONUMENTATION

LIBER 3 PAGE 11

DEC 15 1993

87769

## REMONUMENTATION LAND CORNER RECORDATION CERTIFICATE Filing Requirement of Act 74, Mich. P.A. 1970

RECORDED  
HILLSDALE CO. MICH.  
'93 DEC 8 PM 4 42

*Judy VanZandt*  
REG. OF DEEDS

For corners in

<u>HILLSDALE</u> <small>(County)</small>	Located In:	Corner Code #:	
	6S      3W	F-11 <u>F-13</u> G-9	
1. Public Land Survey	T      R		
	T      R		
	T      R		
	T      R		
2. Property Controlling in Section	S      T      R		
	S      T      R		
3. Miscellaneous Property in Sec.	S      T      R		
	S      T      R		
4. Lot No. _____, Recorded Plat _____			
5. Private Claims _____			

Register of Deeds Stamp & File Number

	A	B	C	D	E	F	G	H	I	J	K	L	M
2	6	5	4	3	2	1							
3													
4	7	8	9	10	11	12							
5													
6	18	17	16	15	14	13							
7													
8	19	20	21	22	23	24							
9													
10	30	29	28	27	26	25							
11													
12	31	32	33	34	35	36							
13													

I, John E. Maxson in a field survey on 8 December, 1993  
do hereby certify that under requirements of P.A. 74, Michigan P.A. of 1970, the corner points mentioned in lines 1 and 2 above were in conformance with regulations and rules therefore as required in the current manual of survey instructions of the United States Department of the Interior, Bureau of Land Management or by a decree of a Court of Law and/or that the corner points mentioned in lines 3, 4 and 5 above were in conformance with the rules of the Michigan Board of Land Surveyors or by a Decree of a Court of Law; established, re-established, monumented, re-monumented, recovered, found as expressed below:

**NOTE: Not more than 4 corners, all in the same town and range, may be recorded on this certificate.**

**A. Description of original monument and accessories and/or subsequent restoration:**

<p>F-11 GLO, 1823, 17 Wood, S35E, 45 lks 19 Wood, N8W, 39 lks Co Sur 1871, Stone Stone, North, 50 lks</p>	<p>F-13 GLO, 1823, 12 Beech, N52E, 39 lks 13 Beech, N25W, 65 lks Co Sur 1871, Stone Stone, North, 50 lks 12 Sycamore, N49E, 50 lks 10 Sycamore, N71W, 80 lks</p>	<p>G-9 GLO, 1823, 16 Oak, S46W, 58 lks 15 Oak, S61E, 23 lks Co Sur 1868, Stone Original Witnesses LCRC, 1972, Hatt, L1, P133 Iron pipe</p>
---	--	--


**B. Description of corner evidence found and/or method applied in restoring or reestablishing corner:**

<p>F-11 Found 1/2" Iron pipe and one witness stone from 1871 record 33 North Accepted as a careful and faithful perpetuation of the original corner</p>	<p>F-13 Found RR Spike and one witness stone from 1871 record 33 North Accepted as a careful and faithful perpetuation of the original corner</p>	<p>G-9 Found Iron pipe as witnessed in Hatt, LCRC, and Accepted as a careful and faithful reestablishment of the original corner</p>
---	---	--

**C. Description of monument for corner and accessories established to perpetuate locating the position of the corner:**

<p>F-11 Reset 5/8 x 36 rebar w/cap in mon. box North 32.15' RR tie Fnc Post South 31.25' Stone Pillar S44W 24.44' P.Pole N72E 68.49' 6"Cedar</p>	<p>F-13 Reset 5/8 x 36 rebar w/cap in mon. box North 33.00' Stone Post S55E 87.25' 60"Oak N80E 111.56' Utility. Box S62W 62.85' 15"Walnut</p>	<p>G-9 Reset 5/8 x 36 rebar w/cap in mon. box S20E 76.39' 12"Oak S32W 64.81' 26"Oak S44W 45.85' 14"Hickory N89W 33.53' 24"Twin Cherry</p>
--	---	---

Signed by *John E. Maxson*  
Surveyor's Michigan License No. 27454

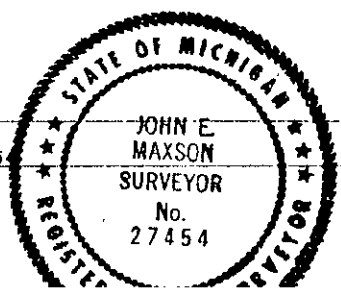

Date 8 December, 1993