

SURVEY & REMONUMENTATION

DEC 15 1993

LIBER 3 PAGE 9

87767

RECORDED
HILLSDALE CO. MICH.

COMMISSION REMONUMENTATION LAND CORNER RECORDATION CERTIFICATE '93 DEC 8 PM 4:42

Filing Requirement of Act 74, Mich. P.A. 1970

For corners in
HILLSDALE
(County)

Located In:

Corner Code #

1. Public Land Survey

6S 3W

G-11, H-13, J-11

2. Property Controlling
in Section

3. Miscellaneous
Property in Sec.

4. Lot No. _____, Recorded Plat _____

5. Private Claims _____

Judy VanZandt
REG. OF DEEDS

Register of Deeds Stamp & File Number

	A	B	C	D	E	F	G	H	I	J	K	L	M
2	6	5	4	3	2	1							
3													
4	7	8	9	10	11	12							
5													
6	18	17	16	15	14	13							
7													
8	19	20	21	22	23	24							
9													
10	30	29	28	27	26	25							
11													
12	31	32	33	34	35	36							
13													

John E. Maxson

8 December

19 93

I, _____, in a field survey on _____, 19 93, do hereby certify that under requirements of P.A. 74, Michigan P.A. of 1970, the corner points mentioned in lines 1 and 2 above were in conformance with regulations and rules therefore as required in the current manual of survey instructions of the United States Department of the Interior, Bureau of Land Management or by a decree of a Court of Law and/or that the corner points mentioned in lines 3, 4 and 5 above were in conformance with the rules of the Michigan Board of Land Surveyors or by a Decree of a Court of Law; established, re-established, monumented, re-monumented, recovered, found as expressed below:

NOTE: Not more than 4 corners, all in the same town and range, may be recorded on this certificate.

A. Description of original monument and accessories and/or subsequent restoration:

G-11
GLO, 1823, 8 Sugar, N17W, 25 1ks
11 Sugar, S59E, 41 1ks
Co Sur 1871, Stone
Stone, North 50 1ks
Stone, South 50 1ks
LCRC, 1973, Hatt, L1, P249
Bolt

H-13
GLO, 1823, 12 Oak, N70E, 27 1ks
15 Oak, N28W, 18 1ks
Co Sur 1871, Stone
16 Butternut, N5E, 128 1ks
30 Oak, N85E, 109.5 1ks

J-11
GLO, 1823, 5 Oak, S80W, 10 1ks
16 Oak, S6E, 98 1ks
Co Sur 1877, Stone
LCRC, 1972, Hatt, L1, P85
RR Spike

B. Description of corner evidence found and/or method applied in restoring or reestablishing corner:

G-11
Found bolt and one witness for Hatt, LCRC, and Accepted as a careful and faithful perpetuation of the original Corner

H-13
Found stone at fence Corner and Accepted as a careful and faithful perpetuation of the original Corner

J-11
Found RR Spike over iron as witnessed from Hatt, LCRC and Accepted as the best available evidence of the position of the original Corner


C. Description of monument for corner and accessories established to perpetuate locating the position of the corner:

G-11
Reset 5/8 x 36 rebar w/cap in mon. box
65E 52.24' 20" Hickory
10W 19.46' P.Pole
45W 57.59' P.Pole
North 33.95' Fence Post

H-13
Reset 5/8 x 36 rebar w/cap.
North 5.60' 18" Cherry
N80E 25.62' 36" Cherry
N60W 52.36' 30" Hickory
West 13.94 6" Hickory

J-11
Reset 5/8 x 36 rebar w/cap in mon. box
N14E 70.42' Top Hydrant
N58W 33.70' P.Pole
S34E 57.95' NW Cor FDN
S82E 13.02' P.Pole

Signed by *John E. Maxson*
Surveyor's Michigan License No. 27454

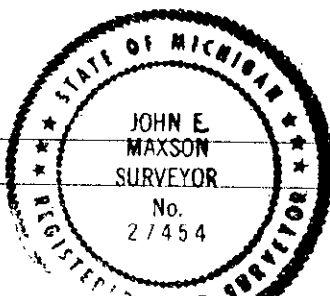

Date 8 December, 1993