

**SURVEY &
REMONUMENTATION**

1993

LIBER 3 PAGE 15

COMMISSION REMONUMENTATION

88317

RECORDED
HILLSDALE CO. MICH.

LAND CORNER RECORDATION CERTIFICATE
Filing Requirement of Act 74, Mich. P.A. 1970

'93 DEC 22 PM 2 19

For corners in

<u>HILLSDALE</u>	Located In:	Corner Code #
1. Public Land Survey	T <u>6S</u> R <u>3W</u>	H-9 <u>H-11</u> I-9
	T _____ R _____	_____
	T _____ R _____	_____
	T _____ R _____	_____
2. Property Controlling in Section	S _____ T _____ R _____	_____
	S _____ T _____ R _____	_____
3. Miscellaneous Property in Sec.	S _____ T _____ R _____	_____

Judy VanZandt
REG. OF DEEDS

Register of Deeds Stamp & File Number

4. Lot No. _____, Recorded Plat _____
5. Private Claims _____

I, John E. Maxson in a field survey on 22 December, 19 93, do hereby certify that under requirements of P.A. 74, Michigan P.A. of 1970, the corner points mentioned in lines 1 and 2 above were in conformance with regulations and rules therefore as required in the current manual of survey instructions of the United States Department of the Interior, Bureau of Land Management or by a decree of a Court of Law and/or that the corner points mentioned in lines 3, 4 and 5 above were in conformance with the rules of the Michigan Board of Land Surveyors or by a Decree of a Court of Law; established, re-established, monumented, re-monumented, recovered, found as expressed below:

A	B	C	D	E	F	G	H	I	J	K	L	M
2	6	5	4	3	2	1						
3												
4	7	8	9	10	11	12						
5												
6	18	17	16	15	14	13						
7												
8	19	20	21	22	23	24						
9												
10	30	29	28	27	26	25						
11												
12	31	32	33	34	35	36						
13												

NOTE: Not more than 4 corners, all in the same town and range, may be recorded on this certificate.

A. Description of original monument and accessories and/or subsequent restoration:

H-9 GLO, 1823, 28 Oak, S40W, 12 lks 14 Oak, N6E, 33 lks Co Sur 1871, Fnc Post LCRC, 1975, Burris, L1, P457 Iron Pipe	H-11 GLO, 1823, 14 Beech, N50W, 3.5 lks 14 Beech, S45E, 54 lks LCRC, 1981, Ringenberg, L2, P42 RR Spike	I-9 GLO, 1823, Co Sur 1877, Stone
---	---	------------------------------------------------


B. Description of corner evidence found and/or method applied in restoring or reestablishing corner:

H-9 Found iron from Burris LCRC and accepted as the best available evidence of the position of the original Corner	H-11 Found RR Spike from Ringenberg LCRC and accepted as the best available evidence of the position of the original Corner	I-9 Found RR Spike and accepted as the best available evidence of the original Corner
---	---	-------------------------------------------------------------------------------------------------

C. Description of monument for corner and accessories established to perpetuate locating the position of the corner:

H-9 Reset 5/8 x 36 rebar w/cap in mon. box N30E 96.90' NE Cor Bldg West 33.00' Iron Pipe S32E 97.98' P.Pole N26E 86.95' Spost of sign base	H-11 Reset 5/8 x 36 rebar w/cap in mon. box N40W 29.72' 18"Ash N18E 20.22' Top Hydrant N68E 41.11' P.Pole S01E 17.15' 18"Elm	I-9 Reset 5/8 x 36 rebar w/cap in mon. box N70E 24.77' P.Pole N77W 41.99' P.Pole N17E 92.48' P.Pole N46W 76.36' P.Pole
---	---	---

Signed by John E. Maxson
Surveyor's Michigan License No. 27454

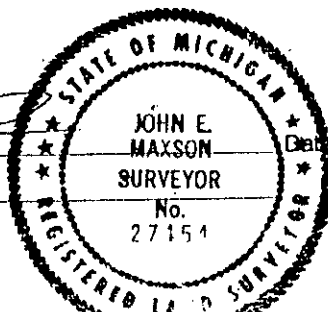

Date: 22 December, 1993