

LIBER 3 PAGE 100
HILLSDALE COUNTY
REMONUMENTATION

RECORDED 107586
HILLSDALE CO. MICH.

LAND CORNER RECORDATION CERTIFICATE
Filing Requirement of Act 74, Mich. P.A. 1970

'95 DEC 15 PM 1 04

Judy VanZandt
REG. OF DEEDS

REGISTER &
COMMISSION

JAN 30 1996

Register of Deeds Stamp & File Number
COMMISSION

For corners in

Hillsdale

(County)

Fayette Twp.

Located In:

Corner Code #

1. Public Land Survey

T 6 S R 3 W

I-5

T R

T R

T R

2. Property Controlling in Section

S T R

3. Miscellaneous Property in Sec.

S T R

S T R

4. Lot No. , Recorded Plat

5. Private Claims

Frederick J.

Cutcher

I, Frederick J. Cutcher, in a field survey on November 27, 1995, do hereby certify that under requirements of P.A. 74, Michigan P.A. of 1970, the corner points mentioned in lines 1 and 2 above were in conformance with regulations and rules therefore as required in the current manual of survey instructions of the United States Department of the Interior, Bureau of Land Management or by a decree of a Court of Law and/or that the corner points mentioned in lines 3, 4 and 5 above were in conformance with the rules of the Michigan Board of Land Surveyors or by a Decree of a Court of Law; established, re-established, monumented, re-monumented, recovered, found as expressed below:

NOTE: Not more than 4 corners, all in the same town and range, may be recorded on this certificate.

A. Description of original monument and accessories and/or subsequent restoration:
Corner common to Sections 10, 11, 14 & 15, Town 6 South, Range 3 West.


Original Government Survey, 1825, Robert Clark, Jr.: Set post, B. Oak 17 in. N. 23° E., 47'; W. Oak 16 in. S. 43½° E., 53.
Survey 890, May 3, 1881, George A. Mark: Stone & brick; Hick. 10 in. N. 11° E., 265½ lks.; Hick. 8 in. S. 14-3/4° E., 145½ lks.

T. Clow, Ringenberg Eng., May 6, 1982: P.K. Nail centerline Hillsdale Rd.; P.K. S. side 6" Box Elder S. 65° W., 39.97'; P.K. S. side P.P. N. 80° E., 33.39'; P.K. S. side P.P. S. 50° E., 24.56'.


B. Description of corner evidence found and/or method applied in restoring or reestablishing corner:
Set P.K. in centerline of Hillsdale Road from two remaining witnesses (hill has been cut extensively).

Two of above references were found.

(Original P.K. was covered in summer of 1985 due to road resurfacing.)

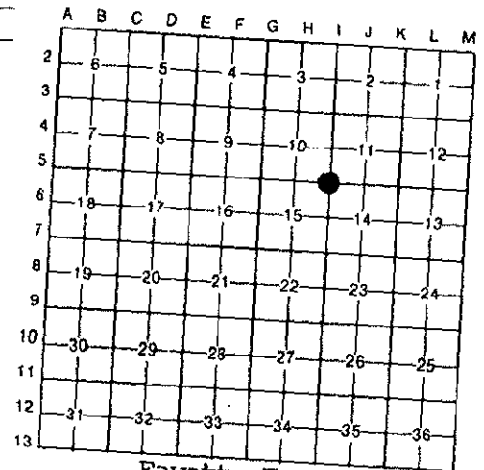

Fayette Twp.

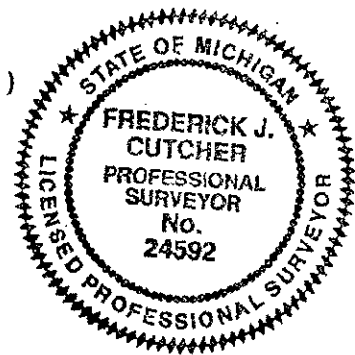

C. Description of monument for corner and accessories established to perpetuate locating the position of the corner:
Replaced P.K. with 3/4"x36" iron road with cap (County issue) in monument box and is accepted as the best available evidence of the position of the original corner.

P.K. S. side P.P. N. 80° E., 33.39'.
P.K. S. side P.P. S. 50° E., 24.56'.
Top cen. tel. stan. S. 78° W., 40.8'.
Nail N.W. side 12" Oak S. 36° W., 56.53'.

Signed by Frederick J. Cutcher
Frederick J. Cutcher

Surveyor's Michigan License No. 24592

Date December 5, 1995