

1993

LIBER 3 PAGE 15

COMMISSION REMONUMENTATION

88317

RECORDED HILLSDALE CO. MICH.

LAND CORNER RECORDATION CERTIFICATE Filing Requirement of Act 74, Mich. P.A. 1970

'93 DEC 22 PM 2 19

For corners in

Form with columns: Located In, Corner Code #. Includes entries for Public Land Survey, Property Controlling in Section, Miscellaneous Property in Sec., Lot No., and Private Claims.

Handwritten signature: Judy VanZandt REG. OF DEEDS

Register of Deeds Stamp & File Number

I, John E. Maxson in a field survey on 22 December, 1993, do hereby certify that under requirements of P.A. 74, Michigan P.A. of 1970, the corner points mentioned in lines 1 and 2 above were in conformance with regulations and rules therefore as required in the current manual of survey instructions of the United States Department of the Interior, Bureau of Land Management or by a decree of a Court of Law and/or that the corner points mentioned in lines 3, 4 and 5 above were in conformance with the rules of the Michigan Board of Land Surveyors or by a Decree of a Court of Law; established, re-established, monumented, re-monumented, recovered, found as expressed below:

Grid table with columns A-M and rows 2-13. Contains numerical values and symbols (circles with crosses) at specific grid intersections.

NOTE: Not more than 4 corners, all in the same town and range, may be recorded on this certificate.

A. Description of original monument and accessories and/or subsequent restoration:

Table with 3 columns: H-9, H-11, I-9. Lists monument details such as 'GLO, 1823, 28 Oak, S40W, 12 lks' and 'LCRC, 1975, Burris, L1, P457 Iron Pipe'.


B. Description of corner evidence found and/or method applied in restoring or reestablishing corner:

Table with 3 columns: H-9, H-11, I-9. Describes evidence found, e.g., 'Found iron from Burris LCRC and accepted as the best available evidence of the position of the original Corner'.

C. Description of monument for corner and accessories established to perpetuate locating the position of the corner:

Table with 3 columns: H-9, H-11, I-9. Lists monument specifications like 'Reset 5/8 x 36 rebar w/cap in mon. box' and bearings/distances.

Signed by [Handwritten Signature] Surveyor's Michigan License No. 27454

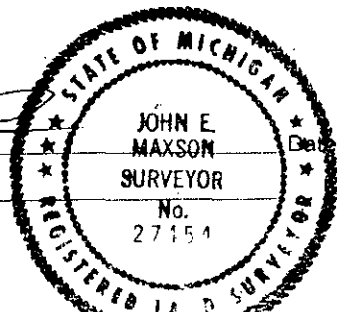

22 December, 1993