

1993

LIBER 3 PAGE 13

COMMISSION

REMONUMENTATION

LAND CORNER RECORDATION CERTIFICATE
Filing Requirement of Act 74, Mich. P.A. 1970

RECORDED 88315
HILLEDALE CO. MICH.

'93 DEC 22 PM 2 19

Handwritten signature: Judy VanZandt
REG. OF DEEDS

For corners in

Form with columns: Located In, Corner Code #. Includes sections for Public Land Survey, Property Controlling in Section, Miscellaneous Property in Sec., Lot No., and Private Claims.

Register of Deeds Stamp & File Number

Grid table with columns A-M and rows 2-13. Contains numbers 1-36 and some circled numbers.

I, John E. Maxson in a field survey on 22 December, 1993, do hereby certify that under requirements of P.A. 74, Michigan P.A. of 1970, the corner points mentioned in lines 1 and 2 above were in conformance with regulations and rules therefor as required in the current manual of survey instructions of the United States Department of the Interior, Bureau of Land Management or by a decree of a Court of Law and/or that the corner points mentioned in lines 3, 4 and 5 above were in conformance with the rules of the Michigan Board of Land Surveyors or by a Decree of a Court of Law; established, re-established, monumented, re-monumented, recovered, found as expressed below:

NOTE: Not more than 4 corners, all in the same town and range, may be recorded on this certificate.

A. Description of original monument and accessories and/or subsequent restoration:

- I-11: GLO, 1823, 30 Oak, N32W, 27 lks; 10 Oak, N80W, 26 lks; LCRC, 1981, Ringenberg L2, P42 Iron in Mon. Box
I-12: GLO, 1823, 17 Oak; South 7.5; 5 Ironwood, N60W, 17 lks; LCRC, 1981, Ringenberg, L2, P42 RR Spike
I-13: GLO, 1823, 10 Beech, N57W, 19 lks; 9 Beech, N53E, 47 lks; LCRC, 1992, Ringenberg, L648, P106 Iron Bar


B. Description of corner evidence found and/or method applied in restoring or reestablishing corner:

- I-11: Found iron from Ringenberg LCRC and accepted as the best available evidence of the position of the original Corner
I-12: Found RR Spike from Ringenberg LCRC and accepted as the best available evidence of the position of the original Corner
I-13: Found Iron Bar and one witness from Ringenberg LCRC and accepted as the best available evidence of the original Corner

C. Description of monument for corner and accessories established to perpetuate locating the position of the corner:

- I-11: reset 5/8 x 36 rebar with cap in mon. box; N40E 41.90' THydrant; S22E 48.84' 14"Maple; S54E 37.27' State Hwy BM; N47E 32.89' State Hwy ref pt; S60W 43.08' State Hwy ref pt
I-12: reset 5/8 x 36 rebar with cap in mon. box; N45E 39.82' 18"Hickory; S53E 64.12' NW Cor Hse#151; N15W 95.13' 18"Hickory; S61W 59.28' 18"Maple
I-13: reset 5/8 x 36 rebar with cap in mon. box; S35W 30.38' 36"Maple; East 11.99' P.Pole; N30W 30.65' 10"Maple; N07E 31.76' SE Cor Brk Pillar

Signed by: [Signature]
Surveyor's Michigan License No. 27454

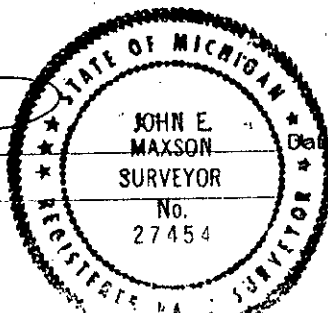

Date: 22 December, 1993