

1993

LIBER 3 PAGE 20

COMMISSION

REMONUMENTATION

88322

RECORDED HILLSDALE CO. MICH.

'93 DEC 22 PM 2 20

LAND CORNER RECORDATION CERTIFICATE

Filing Requirement of Act 74, Mich. P.A. 1970

Judy VanZandt REG. OF DEEDS

For corners in Hillsdale

(County)

Located In:

Corner Code #

Table with 3 columns: Description, Located In (T/R/S), and Corner Code #. Includes entries for Public Land Survey, Property Controlling in Section, and Miscellaneous.

Register of Deeds Stamp & File Number

4. Lot No. Recorded Plat
5. Private Claims

Frederick J. Cutcher

December 21, 1993

I, Frederick J. Cutcher, in a field survey on December 21, 1993, do hereby certify that under requirements of P.A. 74, Michigan P.A. of 1970, the corner points mentioned in lines 1 and 2 above were in conformance with regulations and rules therefore as required in the current manual of survey instructions of the United States Department of the Interior, Bureau of Land Management or by a decree of a Court of Law and/or that the corner points mentioned in lines 3, 4 and 5 above were in conformance with the rules of the Michigan Board of Land Surveyors or by a Decree of a Court of Law; established, re-established, monumented, re-monumented, recovered, found as expressed below:

NOTE: Not more than 4 corners, all in the same town and range, may be recorded on this certificate.

Grid table with columns A-M and rows 2-13. A dot is marked at the intersection of column J and row 7.


A. Description of original monument and accessories and/or subsequent restoration:

LCR Liber 1, Page 357, October 12, 1973 by Robert E. Burris, Sr.:

Set 3/4" x 30" iron pipe at a point halfway between N.E. & N.W. cor. of Sec. 23.

B. Description of corner evidence found and/or method applied in restoring or reestablishing corner:

On this date I found a 3/4" x 30" iron pipe just below gravel surface. Two references per Liber 1, Page 357 of LCR remain.

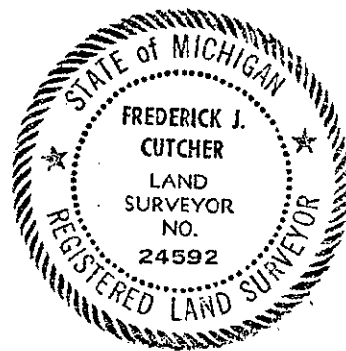

C. Description of monument for corner and accessories established to perpetuate locating the position of the corner:

- Replaced 3/4" x 30" iron pipe with 3/4" x 36" steel rod with cap (County issue). 7'± South of centerline of Mauck Road.
P.K. Nail in S.W. side of 8" Hickory N 12° W 27.2'
P.K. Nail in N. face of R.R. tie fence post S 3° W 21.95'
Nail in W. side of 8" Cherry N 47° E 37.15'
Nail in N. side of Pwr. pole S 52° E 31.83 feet

And is accepted as a careful and faithful reestablishment of the position of the original corner.

Signed by Frederick J. Cutcher Date December 21, 1993
Surveyor's Michigan License No. 24592