

**SURVEY &
REMONUMENTATION**

LIBER 3 PAGE 8'

DEC 15 1993

87766

RECORDED
HILLSDALE CO. MICH.

'93 DEC 8 PM 4 42

**COMMISSION REMONUMENTATION
LAND CORNER RECORDATION CERTIFICATE**
Filing Requirement of Act 74, Mich. P.A. 1970

Judy Varnjandt
REG. OF DEEDS

For corners in

<u>HILLSDALE</u> <small>(County)</small>	Located In:	Corner Code: #
	6S 3W	K-11, L-9, L-11
1. Public Land Survey	T R	
	T R	
	T R	
	T R	
2. Property Controlling in Section	S T R	
	S T R	
3. Miscellaneous Property in Sec.	S T R	
	S T R	
4. Lot No. _____, Recorded Plat _____		
5. Private Claims _____		

Register of Deeds Stamp & File Number

A	B	C	D	E	F	G	H	I	J	K	L	M
2	6	5	4	3	2	1						
3												
4	7	8	9	10	11	12						
5												
6	18	17	16	15	14	13						
7												
8	19	20	21	22	23	24						
9												
10	30	29	28	27	26	25						
11												
12	31	32	33	34	35	36						
13												

I, John E. Maxson, in a field survey on 8 December, 1993, do hereby certify that under requirements of P.A. 74, Michigan P.A. of 1970, the corner points mentioned in lines 1 and 2 above were in conformance with regulations and rules therefore as required in the current manual of survey instructions of the United States Department of the Interior, Bureau of Land Management or by a decree of a Court of Law and/or that the corner points mentioned in lines 3, 4 and 5 above were in conformance with the rules of the Michigan Board of Land Surveyors or by a Decree of a Court of Law; established, re-established, monumented, re-monumented, recovered, found as expressed below:

NOTE: Not more than 4 corners, all in the same town and range, may be recorded on this certificate.

A. Description of original monument and accessories and/or subsequent restoration:

K-11 GLO, 1823, 9 Oak, S25E, 37 lks 15 Oak, S66E, 22 lks Co Sur 1877, Stake ORIGINAL LCRC, 1976, Ringenberg, L1, P505 Iron 33'South centerline	L-9 GLO, 1823, 7 Oak, S30E, 6 lks 8 Oak, N7E, 185 lks Co Sur 1880, Stone, Brick Stone, S45W, 70 lks LCRC, 1971, Hatt, L1, P7 RR Spike Ringenberg Survey, 1982, RR Spike	L-11 GLO, 1823, 9 Poplar, S62W, 15 lks 20 Oak, N24W, 25 lks Burris Survey, 1972, 1/2 Bar 24 Maple, S61W, 38.78 ft 18 Hickory, S48E, 32.94 ft
---	---	--


B. Description of corner evidence found and/or method applied in restoring or reestablishing corner:

K-11 Found capped iron and one witness from Ringenberg LCRC and Accepted as the best available evidence of the position of the original Corner	L-9 Found RR Spike as witnessed on Hatt LCRC and Accepted as the best available evidence of the position of the original Corner	L-11 Found RR Spike as witnessed on record survey and Accepted as the best available evidence of the position of the original Corner
--	---	--

C. Description of monument for corner and accessories established to perpetuate locating the position of the corner:

K-11 Reset 5/8 x 36 rebar w/cap in mon. box S42E 11.74' P.Pole S41E 71.42' 24"Oak S72E 28.34' 18"Cherry N84E 29.93' 14"Hickory	L-9 Reset 5/8 x 36 rebar w/cap in mon. box N50E 35.77' P.Pole S55E 42.37' P.Pole S67W 62.93' P.Pole N05E 39.44' Steel Post	L-11 Reset 5/8 x 36 rebar w/cap in mon. box S17W 19.58' 20"Walnut S45E 33.51' 20"Hickory S80W 83.07' 18"Pine N22E 72.95' P.Pole
--	--	---

Signed by *John E. Maxson*
Surveyor's Michigan License No. 27454

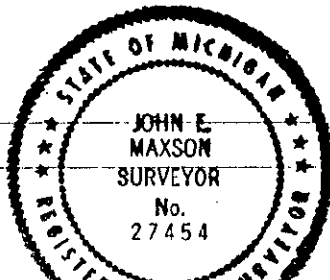

Date 8 December, 1993