

**SURVEY &  
REMONUMENTATION**

LIBER 3 PAGE 10

DEC 15 1993

87768

RECORDED  
HILLSDALE CO. MICH.

**REMONUMENTATION  
CORNER RECORDATION CERTIFICATE**

'93 DEC 8 PM 4 42

Filing Requirement of Act 74, Mich. P.A. 1970

*Judy VanZandt*  
REG. OF DEEDS

For corners in

| HILLSDALE<br>(County)                 | Located In: | Corner Code #/  |
|---------------------------------------|-------------|-----------------|
| 1. Public Land Survey                 | T 6S R 3W   | M-9, M-11, M-13 |
|                                       | T R         |                 |
|                                       | T R         |                 |
|                                       | T R         |                 |
| 2. Property Controlling<br>in Section | S T R       |                 |
|                                       | S T R       |                 |
| 3. Miscellaneous<br>Property in Sec.  | S T R       |                 |
|                                       | S T R       |                 |

Register of Deeds Stamp & File Number

4. Lot No. \_\_\_\_\_, Recorded Plat \_\_\_\_\_  
5. Private Claims \_\_\_\_\_

|    | A  | B | C  | D | E  | F | G  | H | I  | J | K  | L | M |
|----|----|---|----|---|----|---|----|---|----|---|----|---|---|
| 2  | 6  |   | 5  |   | 4  |   | 3  |   | 2  |   | 1  |   |   |
| 3  |    |   |    |   |    |   |    |   |    |   |    |   |   |
| 4  | 7  |   | 8  |   | 9  |   | 10 |   | 11 |   | 12 |   |   |
| 5  |    |   |    |   |    |   |    |   |    |   |    |   |   |
| 6  | 18 |   | 17 |   | 16 |   | 15 |   | 14 |   | 13 |   |   |
| 7  |    |   |    |   |    |   |    |   |    |   |    |   |   |
| 8  | 19 |   | 20 |   | 21 |   | 22 |   | 23 |   | 24 |   |   |
| 9  |    |   |    |   |    |   |    |   |    |   |    |   |   |
| 10 | 30 |   | 29 |   | 28 |   | 27 |   | 26 |   | 25 |   |   |
| 11 |    |   |    |   |    |   |    |   |    |   |    |   |   |
| 12 | 31 |   | 32 |   | 33 |   | 34 |   | 35 |   | 36 |   |   |
| 13 |    |   |    |   |    |   |    |   |    |   |    |   |   |

I, John E. Maxson, in a field survey on 8 December, 1993, do hereby certify that under requirements of P.A. 74, Michigan P.A. of 1970, the corner points mentioned in lines 1 and 2 above were in conformance with regulations and rules therefore as required in the current manual of survey instructions of the United States Department of the Interior, Bureau of Land Management or by a decree of a Court of Law and/or that the corner points mentioned in lines 3, 4 and 5 above were in conformance with the rules of the Michigan Board of Land Surveyors or by a Decree of a Court of Law; established, re-established, monumented, re-monumented, recovered, found as expressed below:

**NOTE: Not more than 4 corners, all in the same town and range, may be recorded on this certificate.**

**A. Description of original monument and accessories and/or subsequent restoration:**

|   |  |   |
|---|--|---|
| <b>M-9</b><br>GLO, 1823, 32 Oak, N83W, 18.5 lks<br>9 Hickory, N26W, 95 lks<br>LCRC, 1980, Ringenberg, L2, P28<br>RR Spike | <b>M-11</b><br>GLO, 1823, 13 Poplar N29W, 65 lks<br>11 Oak, S76W, 42 lks | <b>M-13</b><br>GLO, 1823, 30 Oak, North 9 lks<br>Co Sur 1870, Stone, Stake Brick<br>LCRC, 1981, Ringenberg, L2, P26<br>Crimp pipe |
|---|--|---|


**B. Description of corner evidence found and/or method applied in restoring or reestablishing corner:**

|   |  |  |
|---|--|--|
| <b>M-9</b><br>Found RR Spike as witnessed on Ringenberg LCRC and Accepted as the best available evidence of the position of the original Corner | <b>M-11</b><br>Found iron from record surveys and Accepted as the best available evidence of the position of the original Corner | <b>M-13</b><br>Found crimped pipe as witnessed on Ringenberg LCRC and Accepted as the best available evidence of the position of the original Corner |
|---|--|--|

**C. Description of monument for corner and accessories established to perpetuate locating the position of the corner:**

|  |  |   |
|--|--|---|
| <b>M-9</b><br>Reset 5/8 x 36 rebar w/cap in mon. box<br>N50E 60.95' CL PstConcTri<br>S45W 38.50' E.Edge ConcPost<br>S46E 46.82' NW Cor ConcCap<br>S04W 12.65' RR Spike in Road | <b>M-11</b><br>Reset 5/8 x 36 rebar w/cap in mon. box<br>North 33.00' P.Pole<br>N50E 46.18' P.Pole<br>S27E 59.77' P.Pole | <b>M-13</b><br>Reset 5/8 x 36 rebar w/cap in mon. box<br>S60W 24.33' 6"Oak<br>S20W 39.67' 18"Oak<br>S17E 55.50' P.Pole<br>S05E 13.09' Fnc. Post |
|--|--|---|

Signed by John E. Maxson  
Surveyor's Michigan License No. 27454

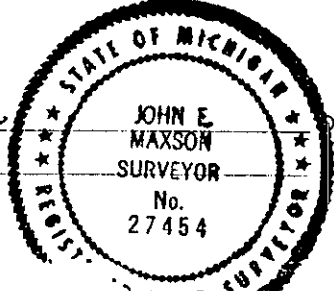

Date 8 December, 1993