

**SURVEY &
REMONUMENTATION**

LIBER 3 PAGE 10

DEC 15 1993

87768

RECORDED
HILLSDALE CO. MICH.

**REMONUMENTATION
CORNER RECORDATION CERTIFICATE**

'93 DEC 8 PM 4 42

Filing Requirement of Act 74, Mich. P.A. 1970

Judy VanZandt
REG. OF DEEDS

For corners in

HILLSDALE
(County)

Located In:

Corner Code #/

1. Public Land Survey	T	6S	R	3W	M-9, M-11, M-13
	T		R		
	T		R		
	T		R		
2. Property Controlling in Section	S		T	R	
	S		T	R	
3. Miscellaneous Property in Sec.	S		T	R	
	S		T	R	

Register of Deeds Stamp & File Number

4. Lot No. _____, Recorded Plat _____
5. Private Claims _____

A	B	C	D	E	F	G	H	I	J	K	L	M
2	6	5	4	3	2	1						
3												
4	7	8	9	10	11	12						
5												
6	18	17	16	15	14	13						
7												
8	19	20	21	22	23	24						
9												
10	30	29	28	27	26	25						
11												
12	31	32	33	34	35	36						
13												

I, John E. Maxson, in a field survey on 8 December, 19 93, do hereby certify that under requirements of P.A. 74, Michigan P.A. of 1970, the corner points mentioned in lines 1 and 2 above were in conformance with regulations and rules therefore as required in the current manual of survey instructions of the United States Department of the Interior, Bureau of Land Management or by a decree of a Court of Law and/or that the corner points mentioned in lines 3, 4 and 5 above were in conformance with the rules of the Michigan Board of Land Surveyors or by a Decree of a Court of Law; established, re-established, monumented, re-monumented, recovered, found as expressed below:

NOTE: Not more than 4 corners, all in the same town and range, may be recorded on this certificate.

A. Description of original monument and accessories and/or subsequent restoration:

M-9 GLO, 1823, 32 Oak, N83W, 18.5 lks 9 Hickory, N26W, 95 lks LCRC, 1980, Ringenberg, L2, P28 RR Spike	M-11 GLO, 1823, 13 Poplar N29W, 65 lks 11 Oak, S76W, 42 lks	M-13 GLO, 1823, 30 Oak, North 9 lks Co Sur 1870, Stone, Stake Brick LCRC, 1981, Ringenberg, L2, P26 Crimp pipe
---	--	---


B. Description of corner evidence found and/or method applied in restoring or reestablishing corner:

M-9 Found RR Spike as witnessed on Ringenberg LCRC and Accepted as the best available evidence of the position of the original Corner	M-11 Found iron from record surveys and Accepted as the best available evidence of the position of the original Corner	M-13 Found crimped pipe as witnessed on Ringenberg LCRC and Accepted as the best available evidence of the position of the original Corner
---	--	--

C. Description of monument for corner and accessories established to perpetuate locating the position of the corner:

M-9 Reset 5/8 x 36 rebar w/cap in mon. box N50E 60.95' CL PstConcTri S45W 38.50' E.Edge ConcPost S46E 46.82' NW Cor ConcCap S04W 12.65' RR Spike in Road	M-11 Reset 5/8 x 36 rebar w/cap in mon. box North 33.00' P: Pole N50E 46.18' P: Pole S27E 59.77 P: Pole	M-13 Reset 5/8 x 36 rebar w/cap in mon. box S60W 24.33' 6" Oak S20W 39.57' 18" Oak S17E 55.50' P: Pole S05E 13.09' Fnc. Post
--	--	--

Signed by John E. Maxson
Surveyor's Michigan License No. 27454

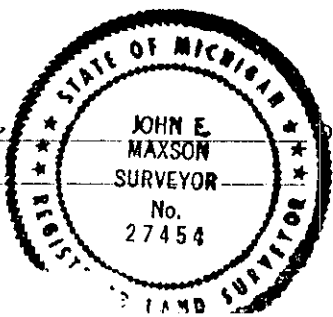

Date 8 December, 1993