



RECORDED 007836 HILLSDALE CO. MICH.

HILLSDALE COUNTY REMONUMENTATION LAND CORNER RECORDATION CERTIFICATE Filing Requirement of Act 74, Mich. P.A. 1970

'98.AUG 5 AM 10 25

Judy VanZandt REG. OF DEEDS

For corners in

<u>Hillsdale</u>	Located In:	Corner Code #
(County)		
1. Public Land Survey	T6S R4 W	C-3
	T R	
	T R	
	T R	
2. Property Controlling in Section	S T R	
	S T R	
3. Miscellaneous Property in Sec.	S T R	
	S T R	

Register of Deeds Stamp & File Number

4. Lot No. _____, Recorded Plat _____
5. Private Claims _____

A	B	C	D	E	F	G	H	I	J	K	L	M
1												
2	6		5		4		3		2		1	
3		●										
4	7		8		9		10		11		12	
5												
6	18		17		16		15		14		13	
7												
8	19		20		21		22		23		24	
9												
10	30		29		28		27		26		25	
11												
12	31		32		33		34		35		36	
13												

I, Frederick J. Cutcher, in a field survey on May 16, 1998 do hereby state that under requirements of P.A. 74, Michigan P.A. of 1970, the corner points mentioned in lines 1 and 2 above were in conformance with regulations and rules therefore as required in the current manual of survey instructions of the United States Department of the Interior, Bureau of Land Management or by a decree of a Court of Law and/or that the corner points mentioned in lines 3, 4 and 5 above were in conformance with the rules of the Michigan Board of Land Surveyors or by a Decree of a Court of Law; established, re-established, monumented, recovered, found as expressed below:

NOTE: Not more than 2 corners, all in the same town and range, may be recorded on this certificate.

A. Description of original monument and accessories and/or subsequent restoration:

Corner common to Sections 5, 6, 7 & 8

G.L.O. by Wm. Brookfield, 1825: Sugar 6" S 31 1/2° W 15 lks; Beech 5" N 59 1/2° E 6 lks.

Survey No. 673, R. Bullard, 5/1/1873: Blue granite 24" and earthen for corner.

LCRC 2685, A. John Hatt, 5/31/72: Found a large stone surrounded with china 9" under gravel road. Witnesses: Nail S.W. side of 26" Maple, N. 50° W. 49.45'; fence corner N. 5° W. 36.20'; Nail E. side of 15" Elm N. 48° W 39.80'.

Notes of Ringenberg, no date: Iron rod: 26" Maple N. 53° 56' W. 46.75'; 15" Oak N. 26° 03' W. 39.5'; corner fence post N. 1° 11' E. 30.5'.

B. Description of corner evidence found and/or method applied in restoring or reestablishing corner:

On 5/16/98 found R.R. spike over large stone, plow point, crockery and 12" bolt. Dug down 36", did not remove stone.

No witnesses were found.

C. Description of monument for corner and accessories established to perpetuate locating the position of the corner:

Angled 3/4" x 36" county remonumentation bar with cap at position of R.R. spike on East edge of large stone and is accepted as the best available evidence of the position of the original corner. Unable to set monument box, due to position of stone. Top of iron is about 5" below gravel road surface and in centerline intersection of VanWert Road and Hog Creek Road.

Northeast corner bottom telephone stan. N. 20° E. 25.75'

Nail & spitter East side 18" Oak N. 25° W. 43.1'


Center of 15" Walnut S. 59° E. 84.4'

Steel corner fence post S. 49° W. 48.73'

Signed by Frederick J. Cutcher
Surveyor's Michigan License No. 24592

Date AUG. 5, 1998

SURVEY & REMONUMENTATION

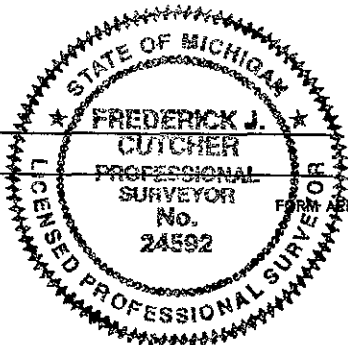

FORM APPROVED BY MICHIGAN STATE BOARD OF PROFESSIONAL SURVEYORS, JAN. 28, 197
REVISED MAY 14, 197
REVISED JAN., 198
REVISED OCT., 199

FEB 23 1999

SECTION