

007833

RECORDED
HILLSDALE CO. MICH.

'98 AUG 5 AM 10 25

Julie VanZandt
REG. OF DEEDS

LIBER 3 PAGE 242

HILLSDALE COUNTY REMONUMENTATION
LAND CORNER RECORDATION CERTIFICATE
Filing Requirement of Act 74, Mich. P.A. 1970

ACCEPTED BY THE HILLSDALE COUNTY
SURVEY PEER GROUP AS THE OFFICIAL
CORNER UNDER MICHIGAN PUBLIC ACT 345
OF 1990. A.D.C.A. MEETING HELD ON
[Signature]
AL RINGENBERG, CO. REC.

For corners in

<u>Hillsdale</u> (County)	Located In:	Corner Code #
1. Public Land Survey	T6 S R4 W	C-6
	T R	
	T R	
	T R	
2. Property Controlling in Section	S T R	
	S T R	
3. Miscellaneous Property in Sec.	S T R	
	S T R	

Register of Deeds Stamp & File Number

4. Lot No. _____, Recorded Plat _____

5. Private Claims _____

I, Frederick J. Cutcher, in a field survey on May 16, 1998 do hereby state that under requirements of P.A. 74, Michigan P.A. of 1970, the corner points mentioned in lines 1 and 2 above were in conformance with regulations and rules therefore as required in the current manual of survey instructions of the United States Department of the Interior, Bureau of Land Management or by a decree of a Court of Law and/or that the corner points mentioned in lines 3, 4 and 5 above were in conformance with the rules of the Michigan Board of Land Surveyors or by a Decree of a Court of Law; established, re-established, monumented, recovered, found as expressed below:

A	B	C	D	E	F	G	H	I	J	K	L	M
1												
2	6		5		4		3		2		1	
3												
4	7		8		9		10		11		12	
5												
6	18	17		16		15		14		13		
7												
8	19	20		21		22		23		24		
9												
10	30	29		28		27		26		25		
11												
12	31	32		33		34		35		36		
13												

NOTE: Not more than 2 corners, all in the same town and range, may be recorded on this certificate.

A. Description of original monument and accessories and/or subsequent restoration:

G.L.O. by Wm. Brookfield, 1825: Red Oak 24" S. 3° E. 40 lks; Red Oak 6" S. 78 1/2° W. 16 lks.

LCRC 2680, A. John Hatt, 5/31/72: Found "T" iron from survey by H.W. Dorsey, May 1969 in C. P. Survey file 3386. Round conc. post East 16.3'; 24" Maple E.N.E. 34.81'; 24" Maple N.N.E. 54.60'; 18" Maple, N.E. 42.52'.

Ringenberg Notes, 4/10/78: Reset 1/2" iron bar, "T" bar badly bent. Conc. fence post East 15.88'; P.K. N.W.'ly root 36" Maple N. 75° E. 33.55'; P.K. N.W.'ly root 24" Maple N. 25° E. 54.20'.

B. Description of corner evidence found and/or method applied in restoring or reestablishing corner:

On 5/16/98 found bent 1/2" iron rod about 2' East of centerline Hog Creek Road, at gravel surface. Dug down and found pieces of brick below iron.

Three witnesses were found.

C. Description of monument for corner and accessories established to perpetuate locating the position of the corner:


Set 3/4" x 36" county remonumentation bar with cap in monument box and is accepted as the best available evidence of the position of the original corner.

Base of concrete fence post East 16.3'
N.E. corner barn S. 64° W. 110.7'
S.E. corner barn S. 43° W. 146.0'
S.W. corner house N. 43° E. 139.1'

Signed by *Frederick J. Cutcher*

Date AUG. 5, 1998

Surveyor's Michigan License No. 24592

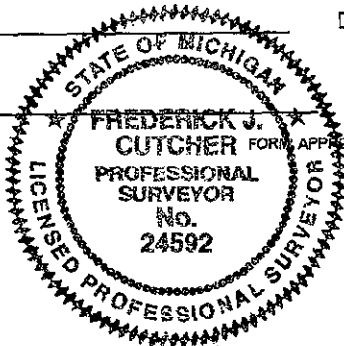

FORM APPROVED BY MICHIGAN STATE BOARD OF PROFESSIONAL SURVEYORS, JAN. 28, 197
REVISED MAY 14, 197
REVISED JAN., 198
REVISED OCT., 199

SURVEY &
REMONUMENTATION

FEB 23 1999

SECTION