

007834

RECORDED
HILLSDALE CO. MICH.
'98 AUG 5 AM 10 25

HILLSDALE COUNTY REMONUMENTATION
LAND CORNER RECORDATION CERTIFICATE
Filing Requirement of Act 74, Mich. P.A. 1970

ACCEPTED BY THE HILLSDALE COUNTY
SURVEY PEER GROUP AS THE OFFICIAL
CORNER UNDER MICHIGAN PUBLIC ACT 345
OF 1996 AT A MEETING HELD ON
AL RINGENBERG, CO. REP.

Judith VanZandt
REG. OF DEEDS

For corners in

<u>Hillsdale</u> (County)	Located In:	Corner Code #
1. Public Land Survey	T6 S R4 W	C-7
	T R	
	T R	
	T R	
2. Property Controlling in Section	S T R	
	S T R	
3. Miscellaneous Property in Sec.	S T R	
	S T R	

Register of Deeds Stamp & File Number

4. Lot No. _____, Recorded Plat _____
5. Private Claims _____

	A	B	C	D	E	F	G	H	I	J	K	L	M
1													
2	6		5		4		3		2		1		
3													
4	7		8		9		10		11		12		
5													
6	18		17		16		15		14		13		
7			●										
8	19		20		21		22		23		24		
9													
10	30		29		28		27		26		25		
11													
12	31		32		33		34		35		36		
13													

I, Frederick J. Cutcher, in a field survey on July 25, 1998 do hereby state that under requirements of P.A. 74, Michigan P.A. of 1970, the corner points mentioned in lines 1 and 2 above were in conformance with regulations and rules therefore as required in the current manual of survey instructions of the United States Department of the Interior, Bureau of Land Management or by a decree of a Court of Law and/or that the corner points mentioned in lines 3, 4 and 5 above were in conformance with the rules of the Michigan Board of Land Surveyors or by a Decree of a Court of Law, established, re-established, monumented, recovered, found as expressed below:

NOTE: Not more than 2 corners, all in the same town and range, may be recorded on this certificate.

A. Description of original monument and accessories and/or subsequent restoration:

G.L.O. by Wm. Brookfield, 1825: W. Oak 40" N. 68° E. 17 lks; W. Oak 30" S. 6 1/2° E. 32 lks.

Survey No. 836, Geo. A. Mark, 7/30/1879: Stone 18", Earthen: W. Oak 12" N. 57 1/2° W. 42 1/4 lks; Cherry 16" S. 74 1/4° W. 40 lks.

Ringenberg & Burris Notes, 4/10/78: Found iron East of centerline, 2' North of fenceline to West. P.K. E. side 30' Oak N. 25° W. 40.41'; P.K. W. side 14" Walnut N. 20° E. 57.15'; Conc. fence post East 19.60'.

B. Description of corner evidence found and/or method applied in restoring or reestablishing corner:

7/25/98: Per LCRC L. 1, P. 111, June 6, 1972 shows corner C-6 to be on line and equal distance between C-5 & C-7. Found corners C-5 and C-6. Iron is gone, therefore extended C-5 and C-6 South equal distance and dug down about 12". Found stone (appears to be tipped to West), broken brick and crockery.

Two witnesses were found.

C. Description of monument for corner and accessories established to perpetuate locating the position of the corner:

Set 3/4" x 36" county remonumentation bar with cap in monument box and is accepted as the best available evidence of the position of the original corner. Remon iron is on East side of stone.

- About in centerline of Hog Creek Road.
- Nail & Spotter N.E. side 36" Oak N. 30° W. 41.35'
- Nail & Spotter W. side 40" Maple S. 26° E. 50.20'
- Nail & Spotter S. side 12" Walnut N. 67° E. 39.70'
- Nail & Spotter N. side 12" Oak S. 83° W. 29.95'
- S.W. corner R.R. tie corner post N. 60° E. 46.30'

Signed by Frederick J. Cutcher


Date AUG. 5, 1998

Surveyor's Michigan License No. 24592

SURVEY &
REMONUMENTATION

FEB 23 1999

SECTION

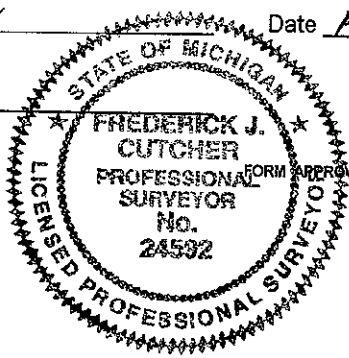

FORM APPROVED BY MICHIGAN STATE BOARD OF PROFESSIONAL SURVEYORS, JAN. 28, 1971
REVISED MAY 14, 197
REVISED JAN., 198
REVISED OCT., 199