

12021

RECORDED
HILLSDALE CO. MICH.

'98 NOV 25 AM 10 02

LIBER 3 PAGE 280
HILLSDALE COUNTY REMONUMENTATION
LAND CORNER RECORDATION CERTIFICATE
Filing Requirement of Act 74, Mich. P.A. 1970

Julie VanZandt
REG. OF DEEDS

For corners in

Hillsdale _____ Located In: _____ Corner Code # _____
(County)

1. Public Land Survey T6 S R4 W C-8 _____
T _____ R _____
T _____ R _____
T _____ R _____

2. Property Controlling S _____ T _____ R _____
in Section S _____ T _____ R _____

3. Miscellaneous S _____ T _____ R _____
Property in Sec. S _____ T _____ R _____

4. Lot No. _____, Recorded Plat _____

5. Private Claims _____

SURVEY &
REMONUMENTATION

FEB 23 1999

SECTION

Register of Deeds Stamp & File Number

I, Frederick J. Cutcher, in a field survey on October 26, 1998 do hereby state that under requirements of P.A. 74, Michigan P.A. of 1970, the corner points mentioned in lines 1 and 2 above were in conformance with regulations and rules therefore as required in the current manual of survey instructions of the United States Department of the Interior, Bureau of Land Management or by a decree of a Court of Law and /or that the corner points mentioned in lines 3, 4 and 5 above were in conformance with the rules of the Michigan Board of Land Surveyors or by a Decree of a Court of Law; established, re-established, monumented, recovered, found as expressed below:

NOTE: Not more than 2 corners, all in the same town and range, may be recorded on this certificate.

A. Description of original monument and accessories and/or subsequent restoration:

G.L.O. by Wm. Brookfield, 1825: Red Oak 16" S. 28° W. 16 lks; Ironwood 10" S. 63-1/2° W. 14 lks.

Survey No. 836, Geo. A. Mark, 7/30/1879: Cherry 24" S. 86° W. 32-1/4 lks.; White Oak 8" S. 82-1/2° E. 53-1/4 lks.

Ringenberg Notes (A.J. Hatt), no date: Iron pipe set 31.60' S. of corner in line with existing fence; Conc. fence post East 22.5'.

B. Description of corner evidence found and/or method applied in restoring or reestablishing corner:

Found 3/4" x 24" iron pipe; top was bent to North (some brick). Could not interpret notes of A.J. Hatt. No witnesses were found. Measured to corner North and to corner South and accepted position of iron pipe found.
See sketch at right.


C. Description of monument for corner and accessories established to perpetuate locating the position of the corner:

Replaced iron pipe with 3/4" x 30" iron with remonumentation cap in monument box and is accepted as the best available evidence of the position of the original corner.

In centerline of N/S gravel road; in line with brush row to East; 2' North of power line.

Set nail & spotter S. side pwr. pole S. 85° E. 37.52'
Set nail & spotter S.E. side 36" Maple N. 40° E. 43.36'
Set nail & spotter E. side 6" Oak N. 10° W. 99.93'
Set nail & spotter S.W. side 12" Oak S. 38° E. 64.90'

1	A	B	C	D	E	F	G	H	I	J	K	L	M
2		6		5		4		3		2		1	
3													
4		7		8		9		10		11		12	
5													
6		18		17		16		15		14		13	
7													
8		19		20		21		22		23		24	
9													
10		30		29		28		27		26		25	
11													
12		31		32		33		34		35		36	
13													

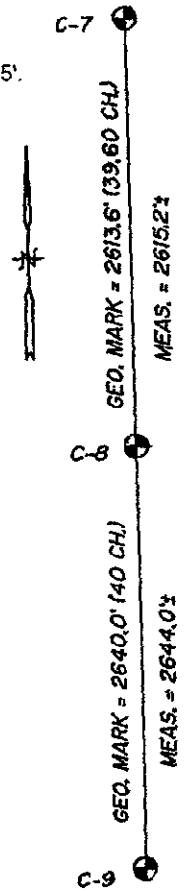

Signed by *Frederick J. Cutcher*

Date 11/4/98

Surveyor's Michigan License No. 24592