

ACCEPTED BY THE HILLSDALE COUNTY SURVEY PEER GROUP AS THE OFFICIAL CORNER UNDER MICHIGAN PUBLIC ACT 345 OF 1952 AS A MEETING HELD ON _____ AL RINGENBERG, CO. REC.

'98 NOV 25 AM 10 02

HILLSDALE COUNTY REMONUMENTATION LAND CORNER RECORDATION CERTIFICATE Filing Requirement of Act 74, Mich. P.A. 1970

Judy VanZandt
REG. OF DEEDS

For corners in

Hillsdale (County)	Located In:	Corner Code #
1. Public Land Survey	T6 S R4 W	C-10
	T ___ R ___	_____
	T ___ R ___	_____
	T ___ R ___	_____
2. Property Controlling in Section	S ___ T ___ R ___	_____
	S ___ T ___ R ___	_____
3. Miscellaneous Property in Sec.	S ___ T ___ R ___	_____
	S ___ T ___ R ___	_____

SURVEY & REMONUMENTATION

FEB 23 1999

SECTION

Register of Deeds Stamp & File Number

4. Lot No. _____, Recorded Plat _____

5. Private Claims _____

I, Frederick J. Cutcher, in a field survey on October 26, 1998 do hereby state that under requirements of P.A. 74, Michigan P.A. of 1970, the corner points mentioned in lines 1 and 2 above were in conformance with regulations and rules therefore as required in the current manual of survey instructions of the United States Department of the Interior, Bureau of Land Management or by a decree of a Court of Law and /or that the corner points mentioned in lines 3, 4 and 5 above were in conformance with the rules of the Michigan Board of Land Surveyors or by a Decree of a Court of Law; established, re-established, monumented, recovered, found as expressed below:

NOTE: Not more than 2 corners, all in the same town and range, may be recorded on this certificate.

	A	B	C	D	E	F	G	H	I	J	K	L	M
1													
2		6		5		4		3		2		1	
3													
4		7		8		9		10		11		12	
5													
6		18		17		16		15		14		13	
7													
8		19		20		21		22		23		24	
9													
10		30		29		28		27		26		25	
11													
12		31		32		33		34		35		36	
13													

A. Description of original monument and accessories and/or subsequent restoration:

G.L.O. by Wm. Brookfield, 1825: White Oak 14" S. 11-1/2° W. 10 lks; White Oak 22" N. 50° W. 7 lks.

LCRC 4553, Glenn A. Fauser, 8/15/78: 1/2" x24" rerod & F&K cap #20707 set from existing occupation-fence East; Oak 10" S. 30° E. 50.45'; Oak 30" N. 85° W. 28.85'; Oak 20" S. 60° W. 32.80'; Maple 24" N. 60° E. 29.92'; fence corner post East 31.00'; Corner is 3' East of centerline Hog Creek Road.

B. Description of corner evidence found and/or method applied in restoring or reestablishing corner:


Found 1/2" x 18" iron rod (bent) 1" below gravel road surface, 4± East of centerline.

Five witnesses were found.

C. Description of monument for corner and accessories established to perpetuate locating the position of the corner:

Replaced iron rod with 3/4" x 30" iron with remonumentation cap in monument box and is accepted as the best available evidence of the position of the original corner.

4± East of centerline of N/S gravel road.
Set nail & spotter N. side 24" Oak S. 68° W. 33.05'
Set nail & spotter E. side 12" Cherry N. 53° W. 37.60'
Set nail & spotter S. side 30" Maple N. 65° E. 30.45'
Set nail & spotter W. side 24" Oak S. 23° E. 50.30'
In line with fence to East.

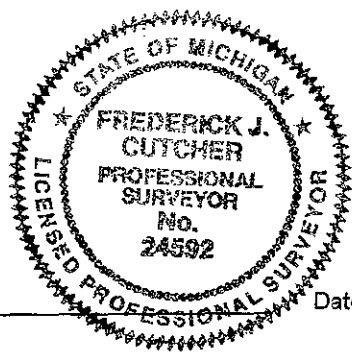

Signed by *Frederick J. Cutcher*

Date 11/4/98

Surveyor's Michigan License No. 24592