

HILLSDALE COUNTY REMONUMENTATION
LAND CORNER RECORDATION CERTIFICATE
Filing Requirement of Act 74, Mich. P.A. 1970

022239

RECORDED
HILLSDALE CO. MICH.

99 SEP -2 AM 9:16

Judy VanJanet
REG. OF DEEDS

For corners in

HILLSDALE Located In: Corner Code #
(County)
ALLEN TWP.

- 1. Public Land Survey T R
- T R
- T R
- T R
- 2. Property Controlling S 5 T 6S R 4W D-1
- in Section S T R
- 3. Miscellaneous S T R
- Property in Sec. S T R

Register of Deeds Stamp & File Number

4. Lot No. , Recorded Plat

5. Private Claims

I, Frederick J. Cutcher, in a field survey on July 26, 1999 do hereby state that under requirements of P.A. 74, Michigan P.A. of 1970, the corner points mentioned in lines 1 and 2 above were in conformance with regulations and rules therefore as required in the current manual of survey instructions of the United States Department of the Interior, Bureau of Land Management or by a decree of a Court of Law and /or that the corner points mentioned in lines 3, 4 and 5 above were in conformance with the rules of the Michigan Board of Land Surveyors or by a Decree of a Court of Law; established, re-established, monumented, recovered, found as expressed below:

NOTE: Not more than 2 corners, all in the same town and range, may be recorded on this certificate.

A. Description of original monument and accessories and/or subsequent restoration:

G.L.O.: No information, this North 1/4 Post was not set in original GLO.

No other information was found for this corner.

B. Description of corner evidence found and/or method applied in restoring or reestablishing corner:


Established corner 1/2 way and on line with C-1 and E-1, Allen Township.

C. Description of monument for corner and accessories established to perpetuate locating the position of the corner:

Set 3/4" diameter iron with County Remonumentation Cap in monument box. This position was not established by original GLO. This corner is accepted as the best available evidence of the position of the corner.

5' South of centerline of Jonesville Road, 74.00' West of D-13, Litchfield Twp.; cen. 20" Maple N. 6° E. 133.2'; face of conc. fence corner post N. 70° E. 82.87'; bottom face tel. stan. N. 67° W. 110.75'; iron w/cap South 28.38'; top center CMP S. 10° W. 15.55'.

1	A	B	C	D	E	F	G	H	I	J	K	L	M
2	6		5		4		3		2		1		
3													
4	7		8		9		10		11		12		
5													
6	18		17		16		15		14		13		
7													
8	19		20		21		22		23		24		
9													
10	30		29		28		27		26		25		
11													
12	31		32		33		34		35		36		
13													

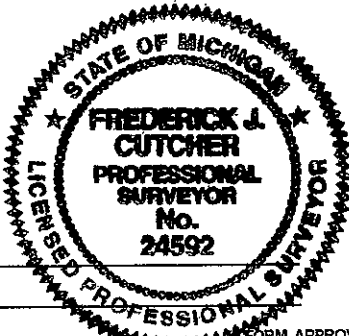

Signed by Frederick J. Cutcher
Surveyor's Michigan License No. 24592

Date 7/30/99