

HILLSDALE COUNTY REMONUMENTATION
LAND CORNER RECORDATION CERTIFICATE
Filing Requirement of Act 74, Mich. P.A. 1970

Judy Vanjunder
REG. OF DEEDS

For corners in

HILLSDALE
(County)
ALLEN TWP.

Located In: Corner Code #

1. Public Land Survey		<u>T6S R4 W</u>	<u>E-1</u>
		T ___ R ___	_____
		T ___ R ___	_____
		T ___ R ___	_____
2. Property Controlling in Section	S ___	T ___ R ___	_____
	S ___	T ___ R ___	_____
3. Miscellaneous Property in Sec.	S ___	T ___ R ___	_____
	S ___	T ___ R ___	_____

Register of Deeds Stamp & File Number

4. Lot No. _____, Recorded Plat _____
5. Private Claims _____

I, Frederick J. Cutcher, in a field survey on July 26, 1999 do hereby state that under requirements of P.A. 74, Michigan P.A. of 1970, the corner points mentioned in lines 1 and 2 above were in conformance with regulations and rules therefore as required in the current manual of survey instructions of the United States Department of the Interior, Bureau of Land Management or by a decree of a Court of Law and /or that the corner points mentioned in lines 3, 4 and 5 above were in conformance with the rules of the Michigan Board of Land Surveyors or by a Decree of a Court of Law; established, re-established, monumented, recovered, found as expressed below:

NOTE: Not more than 2 corners, all in the same town and range, may be recorded on this certificate.

A	B	C	D	E	F	G	H	I	J	K	L	M
1												
2	6		5		4		3		2		1	
3												
4	7		8		9		10		11		12	
5												
6	18		17		16		15		14		13	
7												
8	19		20		21		22		23		24	
9												
10	30		29		28		27		26		25	
11												
12	31		32		33		34		35		36	
13												

A. Description of original monument and accessories and/or subsequent restoration:


G.L.O., 12/14/1825, Wm. Brookfield: Intersected North boundary 120 lks. West of Post (Litchfield); Birch 18" S. 67° W. (no distance); Maple 20" S. 45° E. 25.

Survey No. 1234, 6/1899, Geo. A. Mark: Flat stone 22" and brick; Elm 10" S. 58° E. 75 lks.; Stone & brick East 119-1/4 lks.

B. Description of corner evidence found and/or method applied in restoring or reestablishing corner:

No references remained. Stone and brick was not found.

Set corner on Westerly extension of F-1 and G-1, Allen Township.

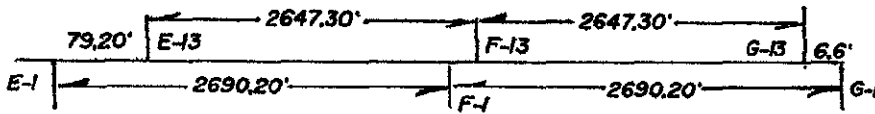

C. Description of monument for corner and accessories established to perpetuate locating the position of the corner:

Set 3/4" diameter iron with County Remonumentation Cap in monument box and is accepted as the best available evidence of the position of the original corner.

2' South of Jonesville Road, 79.20' West of E-13, Litchfield Township: nail & spotter util pole N. 19° W. 168.60'; nail & spotter 12" Oak S. 72° E. 146.70'; stop sign N. 50° E. 79.20'; W. end CMP S. 65° E. 59.63'.

Signed by Frederick J. Cutcher
Surveyor's Michigan License No. 24592



Date 7/30/99