

99 SEP -2 AM 9:16

**HILLSDALE COUNTY REMONUMENTATION
LAND CORNER RECORDATION CERTIFICATE
Filing Requirement of Act 74, Mich. P.A. 1970**

July 20 1999
REG. OF DEEDS

ACCEPTED BY THE HILLSDALE COUNTY SURVEY PEER GROUP AS THE OFFICIAL CORNER UNDER MICHIGAN PUBLIC ACT 74 OF 1970 AT A MEETING HELD ON 8/20/99
Al Ringenberg
AL RINGENBERG, CO. REP.

For corners in

HILLSDALE
(County)
ALLEN TWP.

Located In: Corner Code #

- 1. Public Land Survey T6S R4 W G-1
- T R
- T R
- T R
- 2. Property Controlling S T R
- in Section S T R
- 3. Miscellaneous S T R
- Property in Sec. S T R

Register of Deeds Stamp & File Number

4. Lot No. _____, Recorded Plat _____

5. Private Claims _____

I, Frederick J. Cutcher, in a field survey on July 22, 1999 do hereby state that under requirements of P.A. 74, Michigan P.A. of 1970, the corner points mentioned in lines 1 and 2 above were in conformance with regulations and rules therefore as required in the current manual of survey instructions of the United States Department of the Interior, Bureau of Land Management or by a decree of a Court of Law and /or that the corner points mentioned in lines 3, 4 and 5 above were in conformance with the rules of the Michigan Board of Land Surveyors or by a Decree of a Court of Law; established, re-established, monumented, recovered, found as expressed below:

NOTE: Not more than 2 corners, all in the same town and range, may be recorded on this certificate.

	A	B	C	D	E	F	G	H	I	J	K	L	M
1													
2	6			5			4		3		2		1
3													
4	7			8			9		10		11		12
5													
6	18			17			16		15		14		13
7													
8	19			20			21		22		23		24
9													
10	30			29			28		27		26		25
11													
12	31			32			33		34		35		36
13													

A. Description of original monument and accessories and/or subsequent restoration:

G.L.O., 12/14/1825, Wm. Brookfield: Intersect North boundary 10 lks. East (of G-13, Town 5 South, Range 4 West Litchfield): Poplar 12" S. 25°E. 15; Popple 10" S. 65° W. 43.

Survey No. 1234, June, 1889, Geo. A. Mark: Stone 16" and brick; W. Oak 5" S. 37 1/2° E. 56 lks; stone & brick West 10 lks.

Witness Card 8/21/1989, Ringenberg Eng.: Not noted what was found; p.k. N. side E. pine S. 35° W. 68.54'; p.k. N. side power pole S. 25° E. 44.01'; S.E. cor. phone box N. 50° W. 52.93'.

B. Description of corner evidence found and/or method applied in restoring or reestablishing corner:


Established corner from remaining references: P.K. N. side power pole S. 25° E. 44.01'; 6.6' East of G-13, Litchfield Township.

C. Description of monument for corner and accessories established to perpetuate locating the position of the corner:

Set 3/4" diameter iron with County Remonumentation Cap in monument box and is accepted as the best available evidence of the position of the original corner.

6.6' East of G-13, Litchfield Township, in the intersection of M-49 and Jonesville Road; found p.k. util. pole S. 35° E. 44.01'; top cen. tel. stan. N. 65° W. 73.10'; nail & spotter 18" spruce S. 23° W. 76.98'; cor. conc. curb N. 10° W. 77.62'; cor. conc. curb S. 15° W. 77.81'.

Signed by *Frederick J. Cutcher*
Surveyor's Michigan License No. 24592

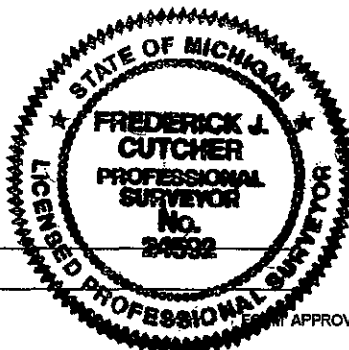

Date 8/20/99