

123929

RECORDED

HILLSDALE CO. MICH.

'97 JUL 11 PM 2 47

*Judy VanZandt*  
REG. DEEDS

ACCEPTED BY THE HILLSDALE COUNTY SURVEY PEER GROUP AS THE OFFICIAL CORNER UNDER MICHIGAN PUBLIC ACT 346 OF 1990 AT A MEETING HELD ON                      AL RINGENBERG, CO. REF

LIBER 3 PAGE 177

HILLSDALE COUNTY REMONUMENTATION CORNER LAND CORNER RECORDATION CERTIFICATE Filing Requirement of Act 74, Mich. P.A. 1970

For corners in

<u>HILLSDALE</u>	Located In:	Corner
Code #		
(County)		
ALLEN TWP.		
1. Public Land Survey	T <u>6</u> S R <u>4</u> W	<u>G-3</u>
	T <u>   </u> R <u>   </u>	<u>          </u>
	T <u>   </u> R <u>   </u>	<u>          </u>
	T <u>   </u> R <u>   </u>	<u>          </u>
2. Property Controlling	S <u>   </u> T <u>   </u> R <u>   </u>	<u>          </u>
in Section	S <u>   </u> T <u>   </u> R <u>   </u>	<u>          </u>
3. Miscellaneous	S <u>   </u> T <u>   </u> R <u>   </u>	<u>          </u>
Property in Sec.	S <u>   </u> T <u>   </u> R <u>   </u>	<u>          </u>

Register of Deeds Stamp & File Number

- 4. Lot No. \_\_\_\_\_, Recorded Plat \_\_\_\_\_
- 5. Private Claims \_\_\_\_\_

I, EDWARD W. REED, in a field survey on JUNE 26, 1997 do hereby state that under requirements of P.A. 74, Michigan P.A. of 1970, the corner points mentioned in lines 1 and 2 above were in conformance with regulations and rules therefore as required in the current manual of Survey instructions of the United States Department of the Interior, Bureau of Land Management or by a decree of a Court of Law and /or that the corner points mentioned in lines 3, 4 and 5 above were in conformance with the rules of the Michigan Board of Land Surveyors or by a Decree of a Court of Law; established, re-established, monumented, recovered, found as expressed below:

NOTE: Not more than 2 corners, all in the same town and range, may be recorded on this certificate.

	A	B	C	D	E	F	G	H	I	J	K	L	M
1													
2	6		5		4		3		2		1		
3							●						
4	7		8		9		10		11		12		
5													
6	18		17		16		15		14		13		
7													
8	19		20		21		22		23		24		
9													
10	30		29		28		27		26		25		
11													
12	31		32		33		34		35		36		
13													

A. Description of original monument and accessories and/or subsequent restoration:  
CORNER COMMON TO SECTIONS 3-4-9-10

1990: JOHN MAXSON, RLS- FOUND 1/2" IRON THAT FITS OCCUPATION AND PROPORTIONATE MEASUREMENT, ACCEPTED AS CORNER, RECORDED IN LCRC # L.614/656

B. Description of corner evidence found and/or method applied in restoring or reestablishing corner:

FOUND 1/2" IRON AS DESCRIBED IN LIBER 614/656

C. Description of monument for corner and accessories established to perpetuate locating the position of the corner:  
SET 3/4"X30" REBAR IRON, REMON CAP IN CI-MONUMENT BOX FLUSH WITH ROAD SURFACE>

PK NAIL E. SIDE 36" DOUBLE OAK- S73W 84.19'

TEL PED, N32W 55.48'

W. END CMP S55W 50.8'

E. END CMP S32E 44.1'


8" CHOCK CHERRY, N34E 78.4'

AND IS ACCEPTED AS A CAREFUL AND FAITHFUL PERPETUATION OF THE POSITION OF THE ORIGINAL CORNER

Signed by *Edward W. Reed* Date JUNE 26, 1997

EDWARD W. REED

Surveyor's Michigan License No. 33985

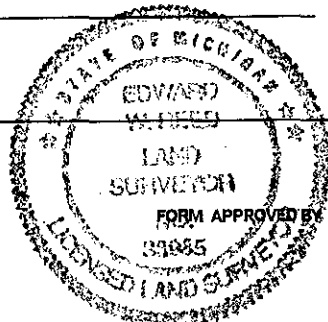

FORM APPROVED BY MICHIGAN STATE BOARD OF PROFESSIONAL SURVEYORS, JAN. 28  
REVISED MAY 14, 1975

REVISED JAN., 198  
REVISED OCT., 199