

123928 RECORDED  
HILLSDALE CO. MICH.

LIBER 3 PAGE 176

HILLSDALE COUNTY REMONUMENTATION CORNER  
LAND CORNER RECORDATION CERTIFICATE  
Filing Requirement of Act 74, Mich. P.A. 1970

'97 JUL 11 PM 2 47

*Judy VanZandt*  
REG. OF DEEDS

ACCEPTED BY THE HILLSDALE COUNTY SURVEY PEER GROUP AS THE OFFICIAL CORNER UNDER MICHIGAN PUBLIC ACT 348 OF 1990 AT A MEETING HELD ON  
*AL RINGENBERG, CD. REC.*

For corners in

HILLSDALE

Located In:

Corner Code

(County)

ALLEN TWP.

1. Public Land Survey

T 6 S R 4 W

G-5

T R

T R

T R

T R

2. Property Controlling in Section

S T R

S T R

3. Miscellaneous Property in Sec.

S T R

S T R

Register of Deeds Stamp & File Number

4. Lot No. \_\_\_\_\_, Recorded Plat \_\_\_\_\_

5. Private Claims \_\_\_\_\_

I, EDWARD W. REED, in a field survey on JUNE 9, 1997 do hereby state that under requirements of P.A. 74, Michigan P.A. of 1970, the corner points mentioned in lines 1 and 2 above were in conformance with regulations and rules therefore as required in the current manual of survey instructions of the United States Department of the Interior, Bureau of Land Management or by a decree of a Court of Law and for that the corner points mentioned in lines 3, 4 and 5 above were in conformance with the rules of the Michigan Board of Land Surveyors or by a Decree of a Court of Law; established, re-established, monumented, recovered, found as expressed below:

NOTE: Not more than 2 corners, all in the same town and range, may be recorded on this certificate.

A	B	C	D	E	F	G	H	I	J	K	L	M
1												
2	6	5	4	3	2	1						
3												
4	7	8	9	10	11	12						
5												
6	18	17	16	15	14	13						
7												
8	19	20	21	22	23	24						
9												
10	30	29	28	27	26	25						
11												
12	31	32	33	34	35	36						
13												

A. Description of original monument and accessories and/or subsequent restoration:  
CORNER COMMON TO SECTIONS 9-10-15-16

RECORDED SUBDIVISION OF THE ORIGINAL PLAT OF THE VILLAGE OF ALLEN, AS RECORDED IN LIBER 61 OF DEEDS, PAGE 1, HILLSDALE COUNTY RECORDS.

1976: ROBERT BURRIS, RLS: RECORDED CORNER AS RR SPIKE IN LCRC # 1300

B. Description of corner evidence found and/or method applied in restoring or reestablishing corner:

FOUND RR SPIKE AS DESCRIBED IN LCRC # 1300

SURVEY & REMONUMENTATION

FEB 11 1998

SECTION

C. Description of monument for corner and accessories established to perpetuate locating the position of the corner:  
SET 3/4"X30" REBAR IRON WITH CAP IN CI-MONUMENT BOX FLUSH WITH ROAD SURFACE

PK NAIL IN S SIDE POWER POLE	N50E 16.47'
NE COR. PORCH	S55W 49.92'
NE COR HOUSE # 114	N42W 64.9'
SE COR HOUSE # 116	S73E 31.3'
C/L OF N-S ROAD	WEST 4.2'


AND IS ACCEPTED AS A CAREFUL AND FAITHFUL PERPETUATION OF THE POSITION OF THE ORIGINAL CORNER

Signed by *Edward W. Reed*

Date JUNE 9, 1997

EDWARD W. REED

Surveyor's Michigan License No. 33985

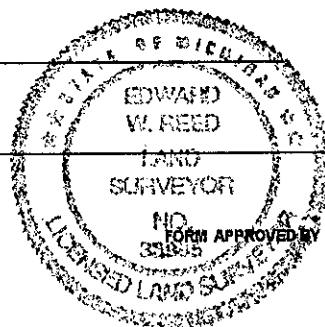

FORM APPROVED BY MICHIGAN STATE BOARD OF PROFESSIONAL SURVEYORS, JAN. 28  
REVISED MAY 14, 1975

REVISED JAN., 198  
REVISED OCT., 199