

ACCEPTED BY THE HILLSDALE COUNTY SURVEY PEER GROUP AS THE OFFICIAL CORNER UNDER MICHIGAN PUBLIC ACT 348 OF 1995-ACCA MEETING HELD ON 11-25-98 AT AL RINGENBERG, CO. TWP.

HILLSDALE COUNTY REMONUMENTATION LAND CORNER RECORDATION CERTIFICATE Filing Requirement of Act 74, Mich. P.A. 1970

'98 NOV 25 AM 10 02

Justin VanZandt
REC. OF DEEDS

For corners in

Hillsdale
(County)

Located In: Corner Code #

- | | | |
|------------------------------------|-----------|-----|
| 1. Public Land Survey | T 6S R 4W | M-9 |
| | T R | |
| | T R | |
| | T R | |
| 2. Property Controlling in Section | S T R | |
| | S T R | |
| 3. Miscellaneous Property in Sec. | S T R | |
| | S T R | |

SURVEY & REMONUMENTATION

FEB 23 1999

SECTION

Register of Deeds Stamp & File Number

4. Lot No. _____, Recorded Plat _____
5. Private Claims _____

I, Frederick J. Cutcher, in a field survey on October 24, 1998 do hereby state that under requirements of P.A. 74, Michigan P.A. of 1970, the corner points mentioned in lines 1 and 2 above were in conformance with regulations and rules therefore as required in the current manual of survey instructions of the United States Department of the Interior, Bureau of Land Management or by a decree of a Court of Law and/or that the corner points mentioned in lines 3, 4 and 5 above were in conformance with the rules of the Michigan Board of Land Surveyors or by a Decree of a Court of Law; established, re-established, monumented, recovered, found as expressed below:

A	B	C	D	E	F	G	H	I	J	K	L	M
1												
2	6	5	4	3	2	1						
3												
4	7	8	9	10	11	12						
5												
6	18	17	16	15	14	13						
7												
8	19	20	21	22	23	24						
9												
10	30	29	28	27	26	25						
11												
12	31	32	33	34	35	36						
13												

NOTE: Not more than 2 corners, all in the same town and range, may be recorded on this certificate.

A. Description of original monument and accessories and/or subsequent restoration:

G.L.O. by Wm. Brookfield, 1825: White Oak 16" N. 25° W. 44 lks; White Oak 11" S. 36° W. 100 lks.

No other information is available.


B. Description of corner evidence found and/or method applied in restoring or reestablishing corner:

Set 3/4" x 30" iron with remonumentation cap in monument box 37.62' (G.L.O. distance) South of corner A-9, T6S, R3W, Hillsdale Twp., and on line between corners A-9 and A-10, T6S, R3W, Hillsdale Township.

C. Description of monument for corner and accessories established to perpetuate locating the position of the corner:

Set 3/4" x 30" iron with remonumentation cap in monument box and is accepted as the best available evidence of the position of the original corner.

4' East of centerline of N/S road.
37.62' South of corner A-9, T6S, R3W, Hillsdale Twp.
Set nail & spotter N.E. side Pwr. pole N. 22° W. 109.20'
Set nail & spotter W. side 36" Oak S. 50° E. 33.58'
Set nail & spotter W. side 12" Maple S. 22° E. 55.90'
S.W. corner conc. curb N. 77° W. 81.64'

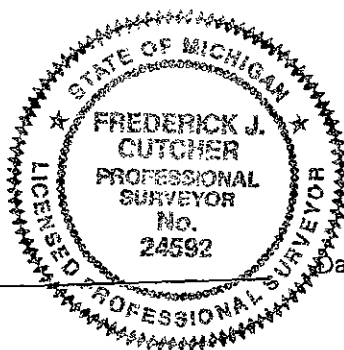

Signed by *Frederick J. Cutcher*

Date 11/4/98

Surveyor's Michigan License No. 24592