

ACCEPTED BY THE HILLSDALE COUNTY SURVEY PEER GROUP AS THE OFFICIAL CORNER UNDER MICHIGAN PUBLIC ACT 345 OF 1990 AT A MEETING HELD ON 10/28/98 AT AL RINGENBERG, CO. REP.

LIBER 3 PAGE 294

RECORDED  
12396 HILLSDALE CO. MICH.

REMONUMENTATION

'98 DEC 4 AM 11 47

LAND CORNER RECORDATION CERTIFICATE  
Filing Requirement of Act 74, Mich. P.A. 1970

*Judy VanZandt*  
REC. OF DEEDS

For corners in

<u>HILLSDALE</u> (County)	Located In:	Corner Code #
1. Public Land Survey	T <u>7S</u> R <u>1W</u>	<u>A-10</u>
	T <u>   </u> R <u>   </u>	<u>   </u>
	T <u>   </u> R <u>   </u>	<u>   </u>
	T <u>   </u> R <u>   </u>	<u>   </u>
2. Property Controlling in Section	S <u>   </u> T <u>   </u> R <u>   </u>	<u>   </u>
	S <u>   </u> T <u>   </u> R <u>   </u>	<u>   </u>
3. Miscellaneous Property in Sec.	S <u>   </u> T <u>   </u> R <u>   </u>	<u>   </u>
	S <u>   </u> T <u>   </u> R <u>   </u>	<u>   </u>

SURVEY & REMONUMENTATION

FEB 23 1999

SECTION

Register of Deeds Stamp & File Number

4. Lot No. \_\_\_\_\_, Recorded Plat \_\_\_\_\_  
5. Private Claims \_\_\_\_\_

I, Jeffrey A. Bieszka, in a field survey on 25 Nov, 1998 do hereby state that under requirements of P.A. 74, Michigan P.A. of 1970, the corner points mentioned in lines 1 and 2 above were in conformance with regulations and rules therefore as required in the current manual of survey instructions of the United States Department of the Interior, Bureau of Land Management or by a decree of a Court of Law and /or that the corner points mentioned in lines 3, 4 and 5 above were in conformance with the rules of the Michigan Board of Land Surveyors or by a Decree of a Court of Law, established, re-established, monumented, recovered, found as expressed below:

NOTE: Not more than 2 corners, all in the same town and range, may be recorded on this certificate.

A	B	C	D	E	F	G	H	I	J	K	L	M
1												
2	6		5		4		3		2		1	
3												
4	7		8		9		10		11		12	
5												
6	18		17		16		15		14		13	
7												
8	19		20		21		22		23		24	
9												
10	30		29		28		27		26		25	
11												
12	31		32		33		34		35		36	
13												

A. Description of original monument and accessories and/or subsequent restoration:

LCRC (Glenn Richard L 1, P 536)  
1/2" iron pipe  
18" Hickory N 20 W 79.95 ft..  
8" Poplar N 70 W 41.48 ft.  
12" Hickory South 96.77 ft.  
21ft. +/- North of Centerline Skuse Road.


County Surveyor (Geo. A. Marks 1882)  
Stake

B. Description of corner evidence found and/or method applied in restoring or reestablishing corner:

Found iron pipe set by Glenn Richard, who found 1" iron bar 37" below surface and 1" iron 21" long over iron bar 16" below surface an railroad spike at surface, dug and found one of the irons as found by Leone. Accepted as the best available evidence to the position of the original corner.

C. Description of monument for corner and accessories established to perpetuate locating the position of the corner:

Set 5/8" x 36" iron w/cap in Monument Box  
Nail & Tag 24" Poplar  
Nail & Tag 6" Beech N 10 E 40.49 ft.  
Nail & Tag 6" Oak S 20 E 57.16 ft.  
Nail & Tag 6" Beech S 05 W 53.23 ft.

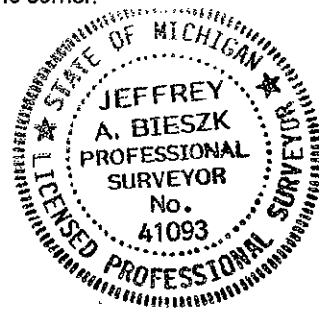

Signed by *[Signature]*  
Surveyor's Michigan License No. 41093

Date 4 December 1998