

REMONUMENTATION
LAND CORNER RECORDATION CERTIFICATE
Filing Requirement of Act 74, Mich. P.A. 1970

'98 DEC 4 AM 11 47

ACCEPTED BY THE HILLSDALE CO. SURVEY PEER GROUP AS THE OFFICIAL CORNER UNDER MICHIGAN PUBLIC ACT 348 OF 1990 AT A MEETING HELD ON 10/6/98 AL RINGENBERG, CO REC.

For corners in

<u>HILLSDALE</u> (County)	Located In:	Corner Code #
1. Public Land Survey	T <u>7S</u> R <u>1W</u>	<u>B-5</u>
	T <u> </u> R <u> </u>	<u> </u>
	T <u> </u> R <u> </u>	<u> </u>
	T <u> </u> R <u> </u>	<u> </u>
2. Property Controlling in Section	S <u> </u> T <u> </u> R <u> </u>	<u> </u>
	S <u> </u> T <u> </u> R <u> </u>	<u> </u>
3. Miscellaneous Property in Sec.	S <u> </u> T <u> </u> R <u> </u>	<u> </u>
	S <u> </u> T <u> </u> R <u> </u>	<u> </u>

Julie VanZandt
REG. OF DEEDS
SURVEY & REMONUMENTATION
FEB 23 1999
SECTION
Register of Deeds Stamp & File Number

- 4. Lot No. _____, Recorded Plat _____
- 5. Private Claims _____

I, Jeffrey A. Bieszk, in a field survey on 25 Nov, 1998 do hereby state that under requirements of P.A. 74, Michigan P.A. of 1970, the corner points mentioned in lines 1 and 2 above were in conformance with regulations and rules therefore as required in the current manual of survey instructions of the United States Department of the Interior, Bureau of Land Management or by a decree of a Court of Law and/or that the corner points mentioned in lines 3, 4 and 5 above were in conformance with the rules of the Michigan Board of Land Surveyors or by a Decree of a Court of Law; established, re-established, monumented, recovered, found as expressed below:

NOTE: Not more than 2 corners, all in the same town and range, may be recorded on this certificate.

1	A	B	C	D	E	F	G	H	I	J	K	L	M
2		6		5		4		3		2		1	
3													
4		7		8		9		10		11		12	
5													
6		18		17		16		15		14		13	
7													
8		19		20		21		22		23		24	
9													
10		30		29		28		27		26		25	
11													
12		31		32		33		34		35		36	
13													

A. Description of original monument and accessories and/or subsequent restoration:


GLO	LCRC L1 P572 Alan Ringenburg
Post	Iron
9" Thorn N11W 85 lks	36" Elm S50W 46.75 ft.
9" W. Ash N68W 101 lks	Phone box South 47.53 ft.

B. Description of corner evidence found and/or method applied in restoring or reestablishing corner:

Found iron as set by Ringenburg who set corner by proportionate distance. Accepted as the best available evidence to the position of the original corner.

C. Description of monument for corner and accessories established to perpetuate locating the position of the corner:

Set 5/8" x 36" iron w/cap in Monument Box
 Nail & Tag 36" Elm S50W 46.75 ft.
 Phone Box South 48.23 ft.
 Nail & Tag Fence Post S40W 60.00 ft.
 Nail & Tag Mulberry Tree S30W 46.30 ft.

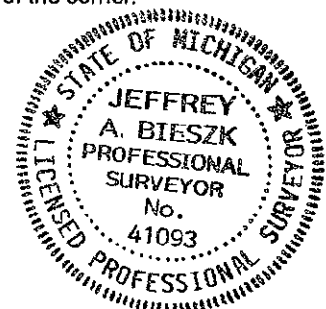

Signed by [Signature]
Surveyor's Michigan License No. 41093

Date 4 December 1998