


97371

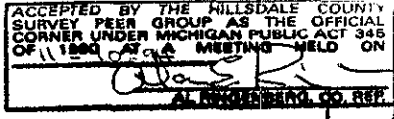

REMONUMENTATION
LAND CORNER RECORDATION CERTIFICATE
Filing Requirement of Act 74, Mich. P.A. 1970

RECORDED
HILLSDALE CO. MICH.
'94 NOV 28 AM 11 07

Judith Namjand
REG. OF DEEDS

For corners in

| | | |
|------------------------------------|-------------------------|---------------|
| <u>Hillsdale</u> (County) | Located In: | Corner Code # |
| 1. Public Land Survey | T <u>7S</u> R <u>2W</u> | <u>C-3</u> |
| | T _____ R _____ | |
| | T _____ R _____ | |
| | T _____ R _____ | |
| 2. Property Controlling in Section | S _____ T _____ R _____ | |
| | S _____ T _____ R _____ | |
| 3. Miscellaneous Property in Sec. | S _____ T _____ R _____ | |
| | S _____ T _____ R _____ | |


SURVEY &
REMONUMENTATION

APR 27 1995

Register of Deeds Stamp & File Number

COMMISSION

- 4. Lot No. _____, Recorded Plat _____
- 5. Private Claims _____

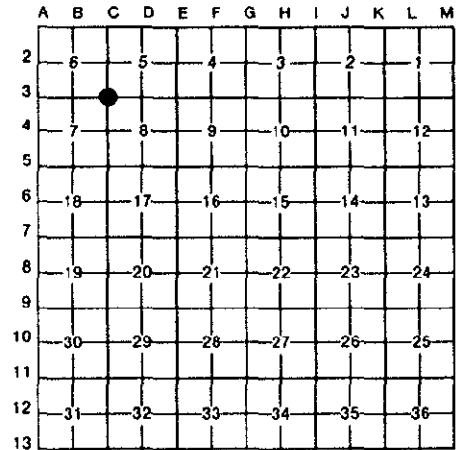

Frederick J.

Cutcher, in a field survey on November 18, 1994

do hereby certify that under requirements of P.A. 74, Michigan P.A. of 1970, the corner points mentioned in lines 1 and 2 above were in conformance with regulations and rules therefore as required in the current manual of survey instructions of the United States Department of the Interior, Bureau of Land Management or by a decree of a Court of Law and/or that the corner points mentioned in lines 3, 4 and 5 above were in conformance with the rules of the Michigan Board of Land Surveyors or by a Decree of a Court of Law; established, re-established, monumented, re-monumented, recovered, found as expressed below:

NOTE: Not more than 4 corners, all in the same town and range, may be recorded on this certificate.

A. Description of original monument and accessories and/or subsequent restoration:

A.E. Ringenberg: Kirt Myers, June 12, 1978: Found concrete monument.

B. Description of corner evidence found and/or method applied in restoring or reestablishing corner:

Found concrete monument on South side of steel fence post, 2' South & 2' West of old fence corner post. Witnesses from K. Myers (6/12/78) found were Cherry East 2.58' and Box Elder North 21.86' (dead). Replaced concrete monument with 3/4"x36" County remonumentation bar and is accepted as a careful and faithful reestablishment of the position of the original corner.

C. Description of monument for corner and accessories established to perpetuate locating the position of the corner:

3/4"x36" County remonumentation bar on S. side of steel fence post
Top center of steel fence post South, 21.95'
Nail N. side 8" Cherry N. 54° W., 19.97'
Top center steel fence post, S. 35° W. 25.50'
Plat of Pleasant View No. 4 is described from this corner



Signed by Frederick J. Cutcher

Date November 27, 1994

Surveyor's Michigan License No. 24592