

'94 NOV 28 AM 11 07



REMONUMENTATION  
LAND CORNER RECORDATION CERTIFICATE  
Filing Requirement of Act 74, Mich. P.A. 1970

Judy VanZandt  
REG. OF DEEDS

For corners in

Hillsdale

(County)

Located In:

Corner Code #

- 1. Public Land Survey T 7S R 2W
- T \_\_\_\_\_ R \_\_\_\_\_
- T \_\_\_\_\_ R \_\_\_\_\_
- T \_\_\_\_\_ R \_\_\_\_\_
- 2. Property Controlling S \_\_\_\_\_ T \_\_\_\_\_ R \_\_\_\_\_
- in Section S \_\_\_\_\_ T \_\_\_\_\_ R \_\_\_\_\_
- 3. Miscellaneous S \_\_\_\_\_ T \_\_\_\_\_ R \_\_\_\_\_
- Property in Sec. S \_\_\_\_\_ T \_\_\_\_\_ R \_\_\_\_\_

D-1

SURVEY &  
REMONUMENTATION

APR 27 1995

Register of Deeds Stamp & File Number

COMMISSION

- 4. Lot No. \_\_\_\_\_, Recorded Plat \_\_\_\_\_
- 5. Private Claims \_\_\_\_\_

A	B	C	D	E	F	G	H	I	J	K	L	M
2	6	5	4	3	2	1						
3												
4	7	8	9	10	11	12						
5												
6	18	17	16	15	14	13						
7												
8	19	20	21	22	23	24						
9												
10	30	29	28	27	26	25						
11												
12	31	32	33	34	35	36						
13												

Frederick J.  
Cutcher

I, \_\_\_\_\_, in a field survey on October 27, 1994, do hereby certify that under requirements of P.A. 74, Michigan P.A. of 1970, the corner points mentioned in lines 1 and 2 above were in conformance with regulations and rules therefore as required in the current manual of survey instructions of the United States Department of the Interior, Bureau of Land Management or by a decree of a Court of Law and/or that the corner points mentioned in lines 3, 4 and 5 above were in conformance with the rules of the Michigan Board of Land Surveyors or by a Decree of a Court of Law; established, re-established, monumented, re-monumented, recovered, found as expressed below:

NOTE: Not more than 4 corners, all in the same town and range, may be recorded on this certificate.

A. Description of original monument and accessories and/or subsequent restoration:

Records of A.E. Ringenberg: T. Clow, Sept. 9, 1980: Found corner 9.5' North of centerline of road and East 74.84' of Sec. 1/4 corner, Sec. 32, T6S, R2W (D-13, T6S, R2W).

This corner was not set on GLO survey.


GLO proration places this corner 74.58' East of D-13, T6S, R2W.

B. Description of corner evidence found and/or method applied in restoring or reestablishing corner:

Found 1/2"x18" iron rod at road surface 9.5' North of centerline. Replaced with 3/4"x36" County remonumentation bar. This position not established by original government surveyors. This monument is accepted as the best available evidence of the position of the corner.

C. Description of monument for corner and accessories established to perpetuate locating the position of the corner:

3/4"x36" County remonumentation bar  
9.5' North of centerline of E/W road and about in line with fence to South  
74.84' East of D-13, T6S, R2W  
Nail & spotter N.W. side 18" Ash, S. 60 W., 46.40'  
Nail & spotter N.E. side 12" Ash, N. 67° W., 41.20'  
Center 4" Spruce N. 35° E., 58.65'

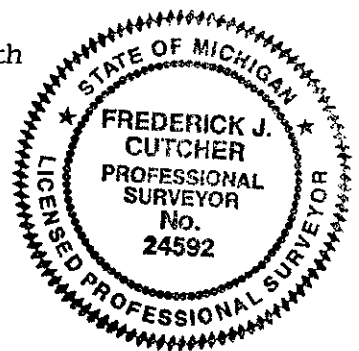

Signed by Frederick J. Cutcher

Date November 27, 1994

Surveyor's Michigan License No. 24592