



107810 RECORDED HILLSDALE CO. MICH.

LIBER 3 PAGE 117 REMONUMENTATION

LAND CORNER RECORDATION CERTIFICATE Filing Requirement of Act 74, Mich. P.A. 1970

'95 DEC 21 PM 3 41

Judy VanZandt REG. OF DEEDS


REGISTER OF DEEDS

JAN 30 1996

Register of Deeds Stamp & File Number COMMISSION

For corners in HILLSDALE (County)

Table with columns: Located In (7S, 2W, D-5), Corner Code #, and numbered rows 1-5 for Public Land Survey, Property Controlling, Miscellaneous, Lot No., and Private Claims.

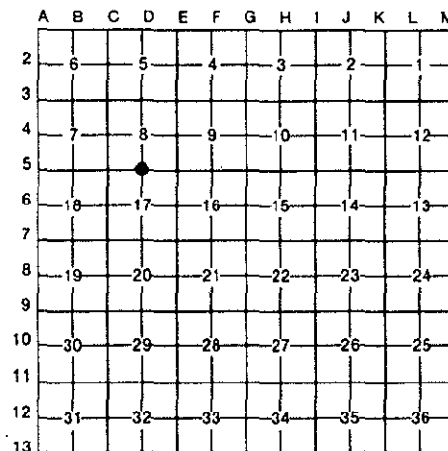

I, JOHN MAXSON, in a field survey on 28 NOVEMBER, 19 95, do hereby certify that under requirements of P.A. 74, Michigan P.A. of 1970, the corner points mentioned in lines 1 and 2 above were in conformance with regulations and rules therefore as required in the current manual of survey instructions of the United States Department of the Interior, Bureau of Land Management or by a decree of a Court of Law and/or that the corner points mentioned in lines 3, 4 and 5 above were in conformance with the rules of the Michigan Board of Land Surveyors or by a Decree of a Court of Law; established, re-established, monumented, re-monumented, recovered, found as expressed below:

NOTE: Not more than 4 corners, all in the same town and range, may be recorded on this certificate.

A. Description of original monument and accessories and/or subsequent restoration:

1825, GLO WILLIAM BROOKFIELD POST S85E 35 lks 9" TAMARACK WEST 60 lks 12" B.ASH

1973 JOHN HATT FOUND IRON UNDER PAVEMENT FROM M.S.H.D. WITNESSES LCRC L1 P261

1978 ALAN RINGENBERG P.K. IN PAVEMENT IN RECORDED SURVEY L1 P550-552

1886, GEORGE MARK STAKE N44W 74.5 lks 4" WILLOW S14E 277.5 lks 16" ELM

N64E 21.18' FNC. POST EAST 18.44' FNC. CORNER N73W 55.23' 13" WALNUT S81E 13.36' ST. RD. SIGN

N64E 21.18' FNC. POST EAST 18.44' FNC. CORNER N73W 55.23' 13" WALNUT


B. Description of corner evidence found and/or method applied in restoring or reestablishing corner:

FOUND P.K AS WITNESSED BY ALAN RINGENBERG AND JOHN HATT, 5 FEET EAST OF INTERSECTION OF LAKE PLEASANT ROAD AND ROSEVILLE ROAD. DUG AND FOUND NO IRON OR ANY SIGN OF OLD STAKE AT THE CORNER. ACCEPTED AS THE BEST AVAILABLE EVIDENCE OF THE POSITION OF THE ORIGINAL CORNER.

C. Description of monument for corner and accessories established to perpetuate locating the position of the corner:

SET 5/8" x 36" REBAR W/CAP

N71W 55.92' 20" WALNUT S71W 52.15' RD. SIGN EAST 18.44' FNC. POST N64E 21.18' FNC. POST

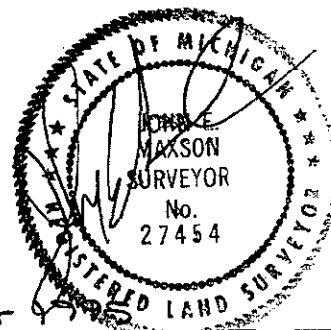

Signed by John E Maxson

Date 21 December 1995

Surveyor's Michigan License No. 27454