

ACCEPTED BY THE HILLSDALE COUNTY SURVEY PEER GROUP AS THE OFFICIAL CORNER UNDER MICHIGAN PUBLIC ACT 348 OF 1990 AT MEETING HELD ON 4-10-94 AL RINGENBERG, CO. REP.

LIBER 3 PAGE 38 97379

RECORDED HILLSDALE CO. MICH. '94 NOV 28 AM 11 07

REMONUMENTATION
LAND CORNER RECORDATION CERTIFICATE
Filing Requirement of Act 74, Mich. P.A. 1970

Judy VanZandt
REG. OF DEEDS

For corners in

Hillsdale
(County)

Located in: _____ Corner Code # _____

1. Public Land Survey T 7S R 2W
T _____ R _____
T _____ R _____
T _____ R _____


2. Property Controlling S _____ T _____
in Section S _____ T _____
3. Miscellaneous S _____ T _____
Property in Sec. S _____ T _____

E-3
**SURVEY &
REMONUMENTATION**
APR 27 1995
COMMISSION

Register of Deeds Stamp & File Number

4. Lot No. _____, Recorded Plat _____
5. Private Claims _____

Frederick J. Cutcher, in a field survey on November 7, 1994, do hereby certify that under requirements of P.A. 74, Michigan P.A. of 1970, the corner points mentioned in lines 1 and 2 above were in conformance with regulations and rules therefore as required in the current manual of survey instructions of the United States Department of the Interior, Bureau of Land Management or by a decree of a Court of Law and/or that the corner points mentioned in lines 3, 4 and 5 above were in conformance with the rules of the Michigan Board of Land Surveyors or by a Decree of a Court of Law; established, re-established, monumented, re-monumented, recovered, found as expressed below:

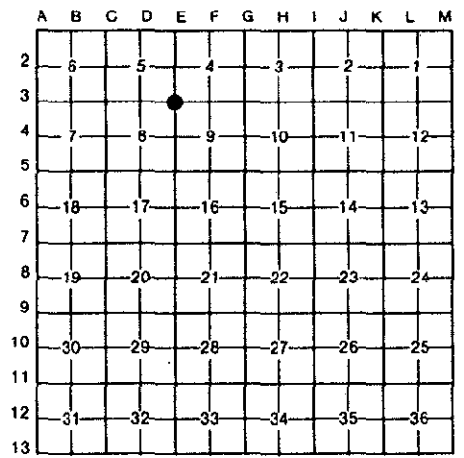

NOTE: Not more than 4 corners, all in the same town and range, may be recorded on this certificate.

A. Description of original monument and accessories and/or subsequent restoration:

Survey #685, Apr. 15, 1874, R. Bullard, County Surveyor: Maple 3 1/2", 50 links West.
R. Cloe, LCRC Liber 1, Page 529, Dec. 1, 1975: Found 1/2" pipe on line of E/W fences. Set 1/2" pipe 8" down in road.

B. Description of corner evidence found and/or method applied in restoring or reestablishing corner:

Found 3/4"x26" iron rod 8" below road surface. Dug to depth of 36" and found nothing else. Replaced iron rod with 3/4"x36" County remonumentation bar and is accepted as a careful and faithful reestablishment of the position of the original corner.

C. Description of monument for corner and accessories established to perpetuate locating the position of the corner:

3/4"x36" County remonumentation bar
In line with East/West fenceline, 5' West of centerline of gravel road
Found nail in S. side 30" Oak, West 23.40'
Found nail in S.E. side 14" Pine, N. 38° E., 59.18'
Found nail in N. side 6" Hickory, S. 50° W., 18.69'
Nail in S. side 12" Pine, N. 70° E., 63.52'



Signed by Frederick J. Cutcher Date November 27, 1994
Surveyor's Michigan License No. 24592