

LIBER 3 PAGE 104
 REMONUMENTATION
LAND CORNER RECORDATION CERTIFICATE
 Filing Requirement of Act 74, Mich. P.A. 1970

107797
 RECORDED
 INDELSDALE CO. MICH.
 '95 DEC 21 PM 3 39

For corners in _____

	Located In:	Corner Code #
	INDRELSDALE	
1. Public Land Survey	T <u>7S</u> R <u>2W</u>	<u>E-4</u>
	T _____ R _____	_____
	T _____ R _____	_____
	T _____ R _____	_____
2. Property Controlling in Section	S _____ T _____ R _____	_____
	S _____ T _____ R _____	_____
3. Miscellaneous Property in Sec.	S _____ T _____ R _____	_____
	S _____ T _____ R _____	_____
4. Lot No. _____, Recorded Plat _____		
5. Private Claims _____		

Judy VanZandt
 REG. OF DEEDS

SURVEY &
 MONUMENTATION

JAN 30 1996

Register of Deeds Stamp & File Number
 COMMISSION

I, JOHN MAXSON, in a field survey on 28 NOVEMBER, 19 95, do hereby certify that under requirements of P.A. 74, Michigan P.A. of 1970, the corner points mentioned in lines 1 and 2 above were in conformance with regulations and rules therefore as required in the current manual of survey instructions of the United States Department of the Interior, Bureau of Land Management or by a decree of a Court of Law and/or that the corner points mentioned in lines 3, 4 and 5 above were in conformance with the rules of the Michigan Board of Land Surveyors or by a Decree of a Court of Law; established, re-established, monumented, re-monumented, recovered, found as expressed below:

	A	B	C	D	E	F	G	H	I	J	K	L	M
2	6	5	4	3	2	1							
3													
4	7	8	9	10	11	12							
5													
6	18	17	16	15	14	13							
7													
8	19	20	21	22	23	24							
9													
10	30	29	28	27	26	25							
11													
12	31	32	33	34	35	36							
13													

NOTE: Not more than 4 corners, all in the same town and range, may be recorded on this certificate.


- A. Description of original monument and accessories and/or subsequent restoration:
- | | |
|---|--|
| 1825, GLO WILLIAM BROOKFIELD
POST
S19E 13 lks 9" W.OAK
S66W 35 lks 11" W.OAK | 1993 ALAN RINGENBERG
SURVEY RECORDED L697 P337
FOUND 3/4" PIPE |
| | N62E 39.28' 15" HICKORY
S77W 26.20' 12" HICKORY
N35W 36.78' 20" CHERRY |

B. Description of corner evidence found and/or method applied in restoring or reestablishing corner:

FOUND CORNER AS RECORDED IN ALAN RINGENBERG SURVEY. IN HIS SURVEY HE MEASURED FROM E-4 TO D-4 (CENTER OF SECTION) AS BEING 2646.79 FEET. THIS LINE WAS ALSO USED IN THE RECORDED PLAT OF "OAK PARK No.2". DUG UNDER IRON FOUND NO OTHER EVIDENCE TO THE CORNER. ACCEPTED CORNER AS A CAREFUL AND FAITHFUL REESTABLISHMENT OF THE ORIGINAL CORNER.

C. Description of monument for corner and accessories established to perpetuate locating the position of the corner:

- SET 5/8" x 36" REBAR W/CAP
- S71W 27.57' 30" HICKORY
 N25W 36.98' 34" CHERRY
 S30E 45.47' 6" CEDAR
 N58E 46.21' FNC. COR.

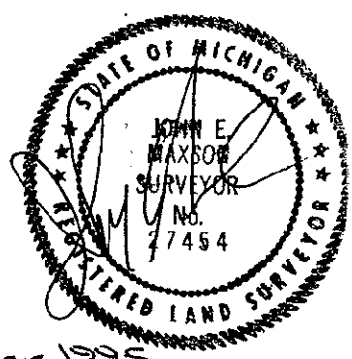

Signed by John E Maxson
 Surveyor's Michigan License No. 27454

Date 21 December 1995