



LIBER 3 PAGE 105 107798
REMONUMENTATION

HILLSDALE CO., MICH.
95 DEC 21 PM 3 40

LAND CORNER RECORDATION CERTIFICATE
Filing Requirement of Act 74, Mich. P.A. 1970

Judy VanZandt
REG. OF DEF.

For corners in

HILLSDALE

(County)

Located In:

Corner Code #

	7S	2W	E-5
1. Public Land Survey	T	R	
	T	R	
	T	R	
	T	R	
2. Property Controlling in Section	S	T	R
	S	T	R
3. Miscellaneous Property in Sec.	S	T	R
	S	T	R

SURVEY & MONUMENTATION


JAN 30 1996

Register of Deeds Stamp & File Number

COMMISSION

- 4. Lot No. _____, Recorded Plat _____
- 5. Private Claims _____

I, JOHN MAXSON, in a field survey on 28 NOVEMBER, 1995, do hereby certify that under requirements of P.A. 74, Michigan P.A. of 1970, the corner points mentioned in lines 1 and 2 above were in conformance with regulations and rules therefore as required in the current manual of survey instructions of the United States Department of the Interior, Bureau of Land Management or by a decree of a Court of Law and/or that the corner points mentioned in lines 3, 4 and 5 above were in conformance with the rules of the Michigan Board of Land Surveyors or by a Decree of a Court of Law; established, re-established, monumented, re-monumented, recovered, found as expressed below:

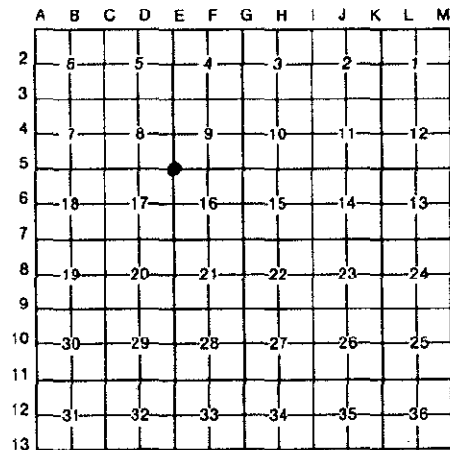

NOTE: Not more than 4 corners, all in the same town and range, may be recorded on this certificate.

A. Description of original monument and accessories and/or subsequent restoration:


- | | |
|---|---|
| 1825 GLO WILLIAM BROOKFIELD
POST
N55W 19 lks 7" TAMARACK
N14E 18 lks 6" TAMARACK | 1973 JOHN HATT
LCRC L1 P259
1/2" SOLID
S43W 24.81' 8" WILLOW
N18W 48.90' 5" WILLOW
N85W 17.50' 5" WILLOW
N18W 58.35' 6" POPLAR
N45E 40.79' FNC. POST |
| 1874 R. BULLARD
STAKE
EAST 50 lks STONE
WEST 50 lks STONE | |

B. Description of corner evidence found and/or method applied in restoring or reestablishing corner:

FOUND IRON IN CENTERLINE OF BLACKBRIDGE AND BOWDITCH ALONG WITH TWO WITNESSES BY JOHN HATT, WHO FOUND IRON PIPE WITH WITNESSES FROM M.S.H.D. AND SET IRON AT THE SURFACE OF THE ROAD. FOUND NO OTHER WITNESSES. DUG AND FOUND NO OTHER EVIDENCE. ACCEPTED IRON AS THE BEST AVAILABLE EVIDENCE OF THE POSITION OF THE ORIGINAL CORNER.

C. Description of monument for corner and accessories established to perpetuate locating the position of the corner:

- SET 5/8" x 36" REBAR W/CAP
- N83W 17.24' 12" WILLOW
- S45W 24.62' 40" WILLOW
- S26W 39.02' 10" WILLOW
- N45E 40.79' FNC. COR.

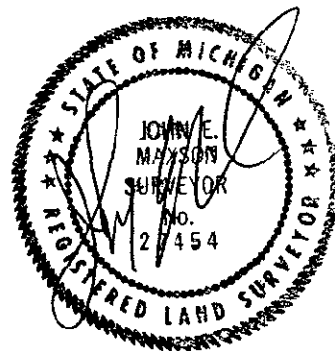

Signed by John E Maxson
Surveyor's Michigan License No. 27454

Date 21 December 1995