

ACCEPTED BY THE HILLSDALE COUNTY SURVEY FEES GROUP AS THE OFFICIAL CORNER UNDER MICHIGAN PUBLIC ACT 345 OF 1995 AT A MEETING HELD ON _____ AL RINGENBERG, CO. REP.

107799

RECORDED
HILLSDALE CO. MICH.

LIBER 3 PAGE 106
REMONUMENTATION

LAND CORNER RECORDATION CERTIFICATE
Filing Requirement of Act 74, Mich. P.A. 1970

'95 DEC 21 PM 3 41

Judy VanZandt
REG. OF DEEDS

SURVEY &
MONUMENTATION

JAN 30 1996

Register of Deeds Stamp & File Number

COMMISSION

For corners in

HILLSDALE

(County)

Located In:

Corner Code -#

7s 2W

F-3

- | | | | | | |
|------------------------------------|---|-------|---|-------|-------|
| 1. Public Land Survey | T | _____ | R | _____ | _____ |
| | T | _____ | R | _____ | _____ |
| | T | _____ | R | _____ | _____ |
| | T | _____ | R | _____ | _____ |
| 2. Property Controlling in Section | S | _____ | T | _____ | R |
| | S | _____ | T | _____ | R |
| 3. Miscellaneous Property in Sec. | S | _____ | T | _____ | R |
| | S | _____ | T | _____ | R |

4. Lot No. _____, Recorded Plat _____

5. Private Claims _____

A	B	C	D	E	F	G	H	I	J	K	L	M
2	6	5	4	3	2	1						
3												
4	7	8	9	10	11	12						
5												
6	18	17	16	15	14	13						
7												
8	19	20	21	22	23	24						
9												
10	30	29	28	27	26	25						
11												
12	31	32	33	34	35	36						
13												

I, JOHN MAXSON, in a field survey on 28 NOVEMBER, 1995

do hereby certify that under requirements of P.A. 74, Michigan P.A. of 1970, the corner points mentioned in lines 1 and 2 above were in conformance with regulations and rules therefore as required in the current manual of survey instructions of the United States Department of the Interior, Bureau of Land Management or by a decree of a Court of Law and/or that the corner points mentioned in lines 3, 4 and 5 above were in conformance with the rules of the Michigan Board of Land Surveyors or by a Decree of a Court of Law; established, re-established, monumented, re-monumented, recovered, found as expressed below:

NOTE: Not more than 4 corners, all in the same town and range, may be recorded on this certificate.

A. Description of original monument and accessories and/or subsequent restoration:

1825 GLO WILLIAM BROOKFIELD
POST
N66W 12 lks 18" W.OAK
S15W 25 lks 12" OAK

1973 RUSSELL COLE
LCRC L1 P309
LCRC L1 P503
1/2" IRON
WEST 36.15' 30" PINE
SW 26.12' 10" HICKORY
SW 39.85' P.POLE
SOUTH 46.24' 12" HICKORY
SOUTH 32.40' STONE

1871 GEORGE MARK
STONE
NO WITNESSES


B. Description of corner evidence found and/or method applied in restoring or reestablishing corner:

FOUND IRON AS WITNESSED BY RUSSELL COLE. FROM COLES LCRC HE STATES THAT HE SET IRON 32.4' NORTH OF A STONE BASED ON MSH DRAWING THAT SHOWED THAT THE STONE FOUND WAS A WITNESS STONE. ALSO FOUND THAT THE IRON FOUND WAS IN LINE OF AN EXISTING FENCE. FROM ALL THE RECORDED DOCUMENTS THE CORNER IS ACCEPTED AS A CAREFUL AND FAITHFUL PERPETUATION OF THE POSITION OF THE ORIGINAL CORNER.

C. Description of monument for corner and accessories established to perpetuate locating the position of the corner:

SET 5/8" x 36" REBAR W/CAP

S82W 36.08' 30" PINE
S20W 39.81' P.POLE
S16W 26.13' 16" HICKORY
S08W 46.42' 16" HICKORY
S80E 45.90' FNC. POST

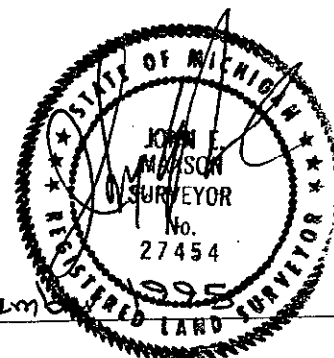

Signed by John E Maxson
Surveyor's Michigan License No. 27454

Date 21 Decemb