

ACCEPTED BY THE HILLSDALE COUNTY SURVEY PEER GROUP AS THE OFFICIAL CORNER UNDER MICHIGAN PUBLIC ACT 345 OF 1990 AT A MEETING HELD ON \_\_\_\_\_ AL RINGENBERG, CO. REP.

LIBER 3 PAGE 109  
REMONUMENTATION

107802

RECORDED  
HILLSDALE CO. MICH.

LAND CORNER RECORDATION CERTIFICATE  
Filing Requirement of Act 74, Mich. P.A. 1970.

'95 DEC 21 PM 3 41

For corners in

HILLSDALE (County)	Located In:	Corner Code #
	7s      2w	1-5
1. Public Land Survey	T _____ R _____	_____
	T _____ R _____	_____
	T _____ R _____	_____
	T _____ R _____	_____
2. Property Controlling in Section	S _____ T _____ R _____	_____
	S _____ T _____ R _____	_____
3. Miscellaneous Property in Sec.	S _____ T _____ R _____	_____
	S _____ T _____ R _____	_____
4. Lot No. _____, Recorded Plat _____		
5. Private Claims _____		

*Judith VanZandt*  
REG. OF DEEDS

SURVEY &  
REMONUMENTATION

JAN 30 1996  
Register of Deeds Stamp & File Number  
COMMISSION

I, JOHN MAXSON, in a field survey on 28 NOVEMBER, 1995, do hereby certify that under requirements of P.A. 74, Michigan P.A. of 1970, the corner points mentioned in lines 1 and 2 above were in conformance with regulations and rules therefore as required in the current manual of survey instructions of the United States Department of the Interior, Bureau of Land Management or by a decree of a Court of Law and/or that the corner points mentioned in lines 3, 4 and 5 above were in conformance with the rules of the Michigan Board of Land Surveyors or by a Decree of a Court of Law; established, re-established, monumented, re-monumented, recovered, found as expressed below:

A	B	C	D	E	F	G	H	I	J	K	L	M
2	6	5	4	3	2	1						
3												
4	7	8	9	10	11	12						
5												
6	18	17	16	15	14	13						
7												
8	19	20	21	22	23	24						
9												
10	30	29	28	27	26	25						
11												
12	31	32	33	34	35	36						
13												

**NOTE: Not more than 4 corners, all in the same town and range, may be recorded on this certificate.**

A. Description of original monument and accessories and/or subsequent restoration:


- |   |  |
|---|--|
| 1825 GLO WILLIAM BROOKFIELD<br>POST<br>S16W 32 lks 20" W.OAK<br>N65E 20 lks 18" W.OAK                       | 1974 JOHN HATT<br>LCRC L1 P399<br>R.R. SPIKE OVER STONE<br>S70W 32.84' 18" OAK<br>S40E 36.18' 18" OAK<br>N40W 37.30' 14" HICKORY |
| 1867, 1876 GEORGE MARK<br>12" STONE, STAKE, EARTHEN<br>S30W 59.5 lks 6" HICKORY<br>N40W 56.5 lks 6" HICKORY |  |

B. Description of corner evidence found and/or method applied in restoring or reestablishing corner:

FOUND R.R. SPIKE AS WITNESSED BY JOHN HATT OVER STONE IN CENTERLINE OF TRIPP ROAD AND PERRINE ROAD. ACCEPTED AS A CAREFUL AND FAITHFUL PERPETUATION OF THE POSITION OF THE ORIGINAL CORNER.

C. Description of monument for corner and accessories established to perpetuate locating the position of the corner:

- SET 5/8" x 36" REBAR W/CAP
- S77W 33.10' 36" OAK  
N60W 38.85' 30" OAK  
N36W 36.95' 28" HICKORY  
S39W 36.22' 30" OAK

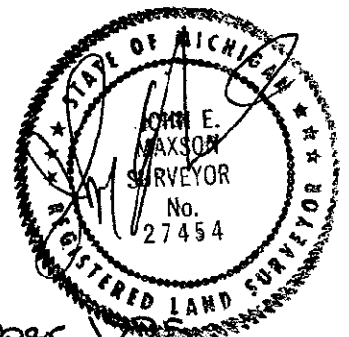

Signed by John E Maxson

Date 21 December 1995

Surveyor's Michigan License No. 27454