

ACCEPTED BY THE HILLSDALE COUNTY SURVEY PEER GROUP AS THE OFFICIAL CORNER UNDER MICHIGAN PUBLIC ACT 345 OF 1950. MEETING HELD ON _____ AL RINGENBERG, CO. REC.

107803 RECORDED
HILLSDALE CO. MICH.
'95 DEC 21 PM 3 41

LIBER 3 PAGE 110
REMONUMENTATION
LAND CORNER RECORDATION CERTIFICATE
Filing Requirement of Act 74, Mich. P.A. 1970

For corners in

	Located In:	Corner Code #
HILLSDALE (County)		
1. Public Land Survey	T 7s R 2W	J-3
	T R	
	T R	
	T R	
2. Property Controlling in Section	S T R	
	S T R	
3. Miscellaneous Property in Sec.	S T R	
	S T R	
4. Lot No. _____, Recorded Plat _____		
5. Private Claims _____		

Judy VanZandt
REG. OF DEEDS
SURVEY & MONUMENTATION
JAN 30 1996
Register of Deeds, Stamp & File Number
COMMISSION

I, JOHN MAXSON, in a field survey on 28 NOVEMBER, 19 95, do hereby certify that under requirements of P.A. 74; Michigan P.A. of 1970, the corner points mentioned in lines 1 and 2 above were in conformance with regulations and rules therefore as required in the current manual of survey instructions of the United States Department of the Interior, Bureau of Land Management or by a decree of a Court of Law and/or that the corner points mentioned in lines 3, 4 and 5 above were in conformance with the rules of the Michigan Board of Land Surveyors or by a Decree of a Court of Law; established, re-established, monumented, re-monumented, recovered, found as expressed below:

	A	B	C	D	E	F	G	H	I	J	K	L	M
2	6	5	4	3	2	1							
3													
4	7	8	9	10	11	12							
5													
6	18	17	16	15	14	13							
7													
8	19	20	21	22	23	24							
9													
10	30	29	28	27	26	25							
11													
12	31	32	33	34	35	36							
13													

NOTE: Not more than 4 corners, all in the same town and range, may be recorded on this certificate.

A. Description of original monument and accessories and/or subsequent restoration:


- 1825 GLO WILLIAM BROOKFIELD POST
- S62E 18 lks 26" R.OAK
- N88W 18 lks 10" HICKORY
- 1878, 1888 GEORGE MARK STONE, BRICK EARTHEN
- S27W 66.5 lks 6" HICKORY

B. Description of corner evidence found and/or method applied in restoring or reestablishing corner:

FOUND SOLID BAR 2 FEET BELOW SURFACE, 2 FEET NORTH OF CENTERLINE AND 4 FEET WEST OF CENTERLINE. FROM MEASUREMENTS ALONG NORTH LINE SECTION 10 AND MEASUREMENT TO A FOUND CENTER OF SECTION WHICH WAS SET BY GEORGE MARK AT A DISTANCE OF 40 CHAINS. COMPARING BETWEEN RECORDED MEASUREMENTS AND TODAY'S MEASUREMENTS THEY WERE ALL PROPORTIONALLY EQUAL. THE IRON IS ACCEPTED AS A CAREFUL AND FAITHFUL REESTABLISHMENT OF THE POSITION OF THE ORIGINAL CORNER.

C. Description of monument for corner and accessories established to perpetuate locating the position of the corner:

- SET 5/8" x 36" REBAR W/CAP
- N81E 117.10' P.POLE
- N50W 45.76' P.POLE
- S13E 68.70' STOP SIGN
- N09W 50.75' STOP SIGN

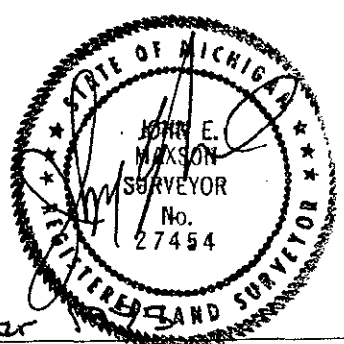

Signed by John E Maxson
Surveyor's Michigan License No. 27454

Date 21 December