

ACCEPTED BY THE HILLSDALE COUNTY SURVEY PEER GROUP AS THE OFFICIAL CORNER UNDER MICHIGAN PUBLIC ACT 345 OF 1890 AT A MEETING HELD ON _____
AL RINGENBERG, CO. REG.

107809

RECORDED
HILLSDALE CO. MICH.

LIBER 3 PAGE 116
REMONUMENTATION
LAND CORNER RECORDATION CERTIFICATE
Filing Requirement of Act 74, Mich. P.A. 1970

'95 DEC 21 PM 3 41

Julie Vamzar
REG. OF DEEDS

For corners in

<u>HILLSDALE</u> (County)	Located In:	Corner Code #
	7S 2W	K-4
1. Public Land Survey	T ___ R ___	_____
	T ___ R ___	_____
	T ___ R ___	_____
	T ___ R ___	_____
2. Property Controlling in Section	S ___ T ___ R ___	_____
	S ___ T ___ R ___	_____
3. Miscellaneous Property in Sec.	S ___ T ___ R ___	_____
	S ___ T ___ R ___	_____
4. Lot No. _____, Recorded Plat _____		
5. Private Claims _____		

JAN 30 1996
Register of Deeds Stamp & File Number
COMMISSION

A	B	C	D	E	F	G	H	I	J	K	L	M
2	6	5	4	3	2	1						
3												
4	7	8	9	10	11	12						
5												
6	18	17	16	15	14	13						
7												
8	19	20	21	22	23	24						
9												
10	30	29	28	27	26	25						
11												
12	31	32	33	34	35	36						
13												

I, JOHN MAXSON, in a field survey on 28 NOVEMBER, 1995, do hereby certify that under requirements of P.A. 74, Michigan P.A. of 1970, the corner points mentioned in lines 1 and 2 above were in conformance with regulations and rules therefore as required in the current manual of survey instructions of the United States Department of the Interior, Bureau of Land Management or by a decree of a Court of Law and/or that the corner points mentioned in lines 3, 4 and 5 above were in conformance with the rules of the Michigan Board of Land Surveyors or by a Decree of a Court of Law; established, re-established, monumented, re-monumented, recovered, found as expressed below:

NOTE: Not more than 4 corners, all in the same town and range, may be recorded on this certificate.

A. Description of original monument and accessories and/or subsequent restoration:

1825 GLO WILLIAM BROOKFIELD
POST
S22W 22 lks 18" BEECH
S87E 17 lks 6" BEECH


1878 GEORGE MARK
REESTABLISHED SET STAKE
N69E 33.25 lks 4" W.ASH

B. Description of corner evidence found and/or method applied in restoring or reestablishing corner:

DID NOT FIND CORNER SET BY GEORGE MARK, BUT GOOD OCCUPATION TO THE WEST. TOOK MEASUREMENTS TO K-3 AND K-4, WHICH IS A STONE ALSO TO THE CENTER OF SECTION FROM WHICH GEORGE MARK SET ALL MEASUREMENTS ARE PROPORTIONATE TO EACH OTHER. ACCEPTED OCCUPATION AS THE BEST AVAILABLE EVIDENCE OF THE POSITION OF THE ORIGINAL CORNER.

C. Description of monument for corner and accessories established to perpetuate locating the position of the corner:

SET 5/8" x 36" REBAR W/CAP
EAST 15.42' 30" CHERRY
WEST 26.51' R.R. FENCE POST
S50W 49.15' 36" POPLAR
N45W 34.10' TWIN ELM

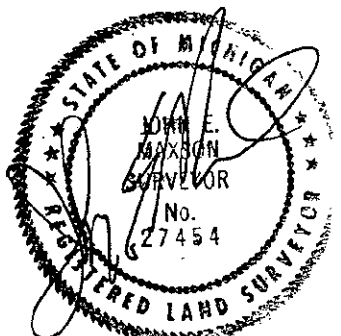

Signed by John E Maxson
Surveyor's Michigan License No. 27454

Date 21 December 1995