

ACCEPTED BY THE HILLSDALE COUNTY SURVEY PEER GROUP AS THE OFFICIAL CORNER UNDER MICHIGAN PUBLIC ACT 345 OF 1975 AT A MEETING HELD ON _____ AL RINGENBERG, CO. REP.

107805

RECORDED
HILLSDALE CO. MICH.

LIBER 3 PAGE 112
REMONUMENTATION
LAND CORNER RECORDATION CERTIFICATE
Filing Requirement of Act 74, Mich. P.A. 1970

'95 DEC 21 PM 3 41

Judith VanZandt
REG. OF DEEDS
CLERK &
RECORDATION

JAN 30 1996

Register of Deeds Stamp & File Number

For corners in

	Located In:	Corner Code #
HILLSDALE		
1. Public Land Survey	T <u>7S</u> R <u>2W</u>	<u>K-5</u>
	T _____ R _____	_____
	T _____ R _____	_____
	T _____ R _____	_____
2. Property Controlling in Section	S _____ T _____ R _____	_____
	S _____ T _____ R _____	_____
3. Miscellaneous Property in Sec.	S _____ T _____ R _____	_____
	S _____ T _____ R _____	_____

4. Lot No. _____, Recorded Plat _____
5. Private Claims _____

I, JOHN MAXSON, in a field survey on 28 NOVEMBER, 1995, do hereby certify that under requirements of P.A. 74, Michigan P.A. of 1970, the corner points mentioned in lines 1 and 2 above were in conformance with regulations and rules therefore as required in the current manual of survey instructions of the United States Department of the Interior, Bureau of Land Management or by a decree of a Court of Law and/or that the corner points mentioned in lines 3, 4 and 5 above were in conformance with the rules of the Michigan Board of Land Surveyors or by a Decree of a Court of Law; established, re-established, monumented, re-monumented, recovered, found as expressed below:

NOTE: Not more than 4 corners, all in the same town and range, may be recorded on this certificate.

	A	B	C	D	E	F	G	H	I	J	K	L	M
2	6		5		4		3		2		1		
3													
4	7		8		9		10		11		12		
5													
6	18		17		16		15		14		13		
7													
8	19		20		21		22		23		24		
9													
10	30		29		28		27		26		25		
11													
12	31		32		33		34		35		36		
13													

A. Description of original monument and accessories and/or subsequent restoration:

1825 GLO WILLIAM BROOKFIELD
POST
S31E 17 lks 28" R.OAK
S74W 12 lks 9" IRONWOOD

1971 JOHN HATT
SURVEY L1 P53
IRON OVER STONE
S36W 32.50' 14" ASH
S16W 46.70' 16" ASH
S82W 15.35' SIGN POST

1867, 1869, 1878, 1882 GEORGE MARK
BOULDER, SMALL STONES STAKE, EARTHEN
N38W 55.25 lks 3" ASH


B. Description of corner evidence found and/or method applied in restoring or reestablishing corner:

FOUND IRON SET BY JOHN HATT WHICH WAS OVER A STONE. ACCEPTED AS A CAREFUL AND FAITHFUL PERPETUATION OF THE POSITION OF THE ORIGINAL CORNER.

C. Description of monument for corner and accessories established to perpetuate locating the position of the corner:

SET 5/8" x 36" REBAR W/CAP

S42W 35.43' 18" ASH
S25E 56.70' PHONE BOX
N77E 43.00' STOP SIGN
N32W 44.00' LILAC

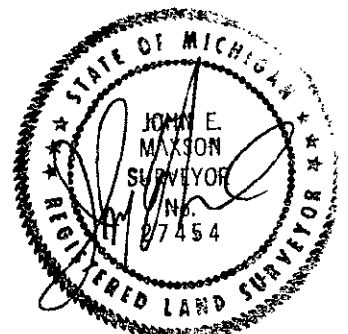

Signed by John E Maxson

Date 21 December 1995

Surveyor's Michigan License No. 27454