

ACCEPTED BY THE HILLSDALE COUNTY SURVEY PEER GROUP AS THE OFFICIAL CORNER UNDER MICHIGAN PUBLIC ACT 345 OF 1990. A MEETING HELD ON [Signature] AT HILLSDALE CO. REG.

LIBER 3 PAGE 213  
HILLSDALE  
REMONUMENTATION

128160

LAND CORNER RECORDATION CERTIFICATE  
Filing Requirement of Act 74, Mich. P.A. 1970

RECORDED  
HILLSDALE CO. MICH.  
97 NOV 12 AM 9 07

For corners in

HILLSDALE (County)	Located In:	Corner Code #
1. Public Land Survey	T <u>7S</u> R <u>3W</u>	<u>B-3</u>
	T _____ R _____	_____
	T _____ R _____	_____
	T _____ R _____	_____
2. Property Controlling in Section	S _____ T _____ R _____	_____
	S _____ T _____ R _____	_____
3. Miscellaneous Property in Sec.	S _____ T _____ R _____	_____
	S _____ T _____ R _____	_____

*Justin VanZandt*  
SURVEY &  
REMONUMENTATION  
FEB 11 1998  
Register of Deeds Stamp & File Number  
SECTION

4. Lot No. \_\_\_\_\_, Recorded Plat \_\_\_\_\_  
5. Private Claims \_\_\_\_\_

	A	B	C	D	E	F	G	H	I	J	K	L	M
2	6		5		4		3		2		1		
3		●											
4	7		8		9		10		11		12		
5													
6	18		17		16		15		14		13		
7													
8	19		20		21		22		23		24		
9													
10	30		29		28		27		26		25		
11													
12	31		32		33		34		35		36		
13													

Frederick J. Cutcher, in a field survey on 11/7, 19 97, do hereby certify that under requirements of P.A. 74, Michigan P.A. of 1970, the corner points mentioned in lines 1 and 2 above were in conformance with regulations and rules therefore as required in the current manual of survey instructions of the United States Department of the Interior, Bureau of Land Management or by a decree of a Court of Law and/or that the corner points mentioned in lines 3, 4 and 5 above were in conformance with the rules of the Michigan Board of Land Surveyors or by a Decree of a Court of Law; established, re-established, monumented, re-monumented, recovered, found as expressed below:

NOTE: Not more than 4 corners, all in the same town and range, may be recorded on this certificate.

A. Description of original monument and accessories and/or subsequent restoration:


G.L.O. by Wm. Brookfield, 1825: W. Oak 30" S. 43° E. 37 lks; W. Oak 22" S. 50¼° W. 34 lks.  
Edward R. Reed, 4/23/78: LCRC 3980 (Liber 1, Pg. 583): Fd. R.R. spike in pavement from witnesses from Ringenberg & Burris Land Surveyors, 1974; S. 25° W. 30.26' N. cor. concrete triangle post; N. 10° W. 29.87' C/L road sign; S. 45° E. 39.7' C/L R.R. sign; S. 25° W. 35.3' pwr. pole; East 49.6' W. rail of railroad.

B. Description of corner evidence found and/or method applied in restoring or reestablishing corner:

On 11-7-97 I found a R.R. spike in the centerline of Bankers Road from LCRC Liber 1, Pg. 583, July 28, 1978, witnesses.  
Three witnesses were found.

C. Description of monument for corner and accessories established to perpetuate locating the position of the corner:

Replaced R.R. spike with County remonumentation bar with cap in monument box and is accepted as best available evidence of the position of the original corner.  
In centerline Bankers Rd.  
In line with railroad right of way fence running S. 25° W.  
Nail & spotter Westerly side pwr. pole S. 25° W. 35.73'  
Northerly corner triangle concrete post S. 25° W. 30.28'  
Westerly rail track S. 65° E. 49.6'  
Yield sign N. 20° W. 22.3'

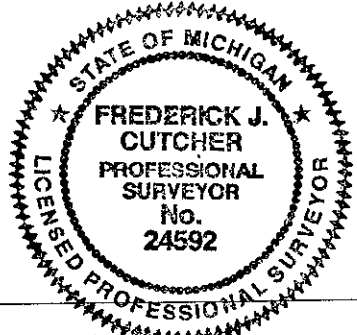

Signed by Frederick J. Cutcher Date 11/10/97

Surveyor's Michigan License No. Frederick J. Cutcher 24592