

128161


HILLSDALE  
REMONUMENTATION

RECORDED  
HILLSDALE CO. MICH.

LAND CORNER RECORDATION CERTIFICATE

Filing Requirement of Act 74, Mich. P.A. 1970

'97 NOV 12 AM 9 07

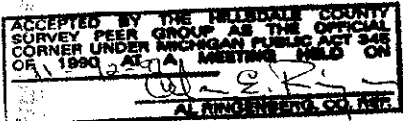

*Judy VanZandt*  
REC'D DEEDS

SURVEY &  
REMONUMENTATION

FEB 11 1998

Register of Deeds Stamp & File Number

SECTION

For corners in HILLSDALE Located In: \_\_\_\_\_ Corner Code # \_\_\_\_\_  
(County)

1. Public Land Survey T 7S R 3W \_\_\_\_\_ B-5 \_\_\_\_\_  
T \_\_\_\_\_ R \_\_\_\_\_  
T \_\_\_\_\_ R \_\_\_\_\_  
T \_\_\_\_\_ R \_\_\_\_\_

2. Property Controlling S \_\_\_\_\_ T \_\_\_\_\_ R \_\_\_\_\_  
in Section S \_\_\_\_\_ T \_\_\_\_\_ R \_\_\_\_\_

3. Miscellaneous S \_\_\_\_\_ T \_\_\_\_\_ R \_\_\_\_\_  
Property in Sec. S \_\_\_\_\_ T \_\_\_\_\_ R \_\_\_\_\_

4. Lot No. \_\_\_\_\_, Recorded Plat \_\_\_\_\_

5. Private Claims \_\_\_\_\_

	A	B	C	D	E	F	G	H	I	J	K	L	M
2	6	5	4	3	2	1							
3													
4	7	8	9	10	11	12							
5	●												
6	18	17	16	15	14	13							
7													
8	19	20	21	22	23	24							
9													
10	30	29	28	27	26	25							
11													
12	31	32	33	34	35	36							
13													

Frederick J. Cutcher, in a field survey on 11/7, 1997, do hereby certify that under requirements of P.A. 74, Michigan P.A. of 1970, the corner points mentioned in lines 1 and 2 above were in conformance with regulations and rules therefore as required in the current manual of survey instructions of the United States Department of the Interior, Bureau of Land Management or by a decree of a Court of Law and/or that the corner points mentioned in lines 3, 4 and 5 above were in conformance with the rules of the Michigan Board of Land Surveyors or by a Decree of a Court of Law; established, re-established, monumented, re-monumented, recovered, found as expressed below:

NOTE: Not more than 4 corners, all in the same town and range, may be recorded on this certificate.

A. Description of original monument and accessories and/or subsequent restoration:  
 G.L.O. by Wm. Brookfield, 1825: Beech 8" N. 71° W. 15 lks.; Beech 13" S. 45° 40' W. 23 lks.  
 Edward R. Reed, 4/23/78: LCRC 3980 (Liber 1, Pg. 583): Fd. R.R. spike in pavement from witnesses from Ringenberg & Burris Land Surveyors, 1974; N. 64° W. 71.37' P.K. nail S. side pwr. pole; N. 38° E. 40.11' P.K. nail N.W. side 40" Maple; N. 73° E. 24.60' P.K. nail S. side 30" Maple.

B. Description of corner evidence found and/or method applied in restoring or reestablishing corner:  
 On 11-7-97 I found a R.R. spike in the centerline intersection of roads and in line with fence to East from LCRC Liber 1, Pg. 583, July 28, 1978, witnesses.  
 Three witnesses were found.

C. Description of monument for corner and accessories established to perpetuate locating the position of the corner:  
 I replaced R.R. spike with County remonumentation bar with cap in monument box and is accepted as best available evidence of the position of the original corner.  
 In centerline intersection of roads West and North and South. In line with fence to East.  
 Nail & spotter N. side R.R. tie post East 29.70'  
 Face of wood post East 22.0'  
 Nail & spotter S. side 24" Maple N. 73° E. 24.58'  
 Nail & spotter N. side pwr. pole N. 65° W. 71.30'  
 Nail & spotter N.W. side pwr. pole S. 20° W. 87.65'

Signed by *Frederick J. Cutcher* Date 11/10/97  
 Surveyor's Michigan License No. Frederick J. Cutcher 24592

