

RECORDED
HILLSDALE CO. MICH.

127738

'97 OCT 30 AM 10 18

LIBER 3 PAGE 197
HILLSDALE COUNTY REMONUMENTATION
LAND CORNER RECORDATION CERTIFICATE
Filing Requirement of Act 74, Mich. P.A. 1970

Judy VanZandt
REC. OF DEEDS

SURVEY &
REMONUMENTATION

FEB 11 1998

Register of Deeds Stamp & File Number
SECTION

ACCEPTED BY THE HILLSDALE COUNTY
SURVEY PEER GROUP AS THE OFFICIAL
CORNER UNDER MICHIGAN PUBLIC ACT 345
OF 1990 AT A MEETING HELD ON
Al Ringenberg
AL RINGENBERG, CO. REC.

For corners in

<u>Hillsdale</u> (County)	Located In:	Corner Code #
1. Public Land Survey	T ___ R ___	_____
	T ___ R ___	_____
	T ___ R ___	_____
	T ___ R ___	_____
2. Property Controlling in Section	S <u>4</u> T <u>7S</u> R <u>3W</u>	<u>F-1</u>
	S ___ T ___ R ___	_____
3. Miscellaneous Property in Sec.	S ___ T ___ R ___	_____
	S ___ T ___ R ___	_____
4. Lot No. _____, Recorded Plat _____		
5. Private Claims _____		

1	A	B	C	D	E	F	G	H	I	J	K	L	M
2		6		5		4		3		2		1	
3													
4		7		8		9		10		11		12	
5													
6		18		17		16		15		14		13	
7													
8		19		20		21		22		23		24	
9													
10		30		29		28		27		26		25	
11													
12		31		32		33		34		35		36	
13													

Frederick J. Cutcher, in a field survey on 9/23, 1997 do hereby state that under requirements of P.A. 74, Michigan P.A. of 1970, the corner points mentioned in lines 1 and 2 above were in conformance with regulations and rules therefore as required in the current manual of survey instructions of the United States Department of the Interior, Bureau of Land Management or by a decree of a Court of Law and/or that the corner points mentioned in lines 3, 4 and 5 above were in conformance with the rules of the Michigan Board of Land Surveyors or by a Decree of a Court of Law; established, re-established, monumented, recovered, found as expressed below:

NOTE: Not more than 2 corners, all in the same town and range, may be recorded on this certificate.


A. Description of original monument and accessories and/or subsequent restoration:

This corner was not set during the Original Government Survey.

No information was available regarding this corner. No references given.

B. Description of corner evidence found and/or method applied in restoring or reestablishing corner:

On 9-23-97 I found nothing. Measured East 53.79' (G.L.O. proration) from F-13 South 1/4 post, Section 33, Town 6 South, Range 3 West, to establish corner.

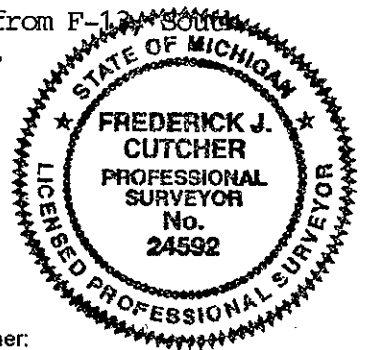

C. Description of monument for corner and accessories established to perpetuate locating the position of the corner:

I set a County remonumentation bar and cap in a monument box 53.79' (G.L.O. proration) East of F-13, S. 1/4 Post, Section 33, Town 6 South, Range 3 West. Fits fence/occupation to South. This position was not established by the original government surveyors. This monument is accepted as the best available evidence of the position of the corner.

In centerline Bankers Road. In line with fence to South.
Nail & spotter W. side R.R. tie post South 37.20'; Top cen. tel. stan. S. 60° W. 46.95';
Top cen. tel. stan. N. 70° E. 60.56'; Top cen. E. end C.M.P. drive culvert N. 54° W. 33.65'; Cen. 12" Hickory S. 43° E. 70.95'.

Signed by *Frederick J. Cutcher*
Surveyor's Michigan License No. Frederick J. Cutcher 24592

Date October 29, 1997