



127735

LIBER 3 PAGE 194  
HILLSDALE COUNTY REMONUMENTATION  
LAND CORNER RECORDATION CERTIFICATE  
Filing Requirement of Act 74, Mich. P.A. 1970

RECORDED  
HILLSDALE CO. MICH.

'97 OCT 30 AM 10 18

Judy VanZandt  
REG. OF DEEDS

For corners in

Hillsdale  
(County)

Located In: Corner Code #


- 1. Public Land Survey T 7S R 3W T-3  
T     R          
T     R          
T     R
- 2. Property Controlling in Section S     T     R      
S     T     R
- 3. Miscellaneous Property in Sec. S     T     R      
S     T     R

SURVEY & REMONUMENTATION

FEB 11 1998

Register Stamp & File Number

- 4. Lot No. \_\_\_\_\_, Recorded Plat \_\_\_\_\_
- 5. Private Claims \_\_\_\_\_

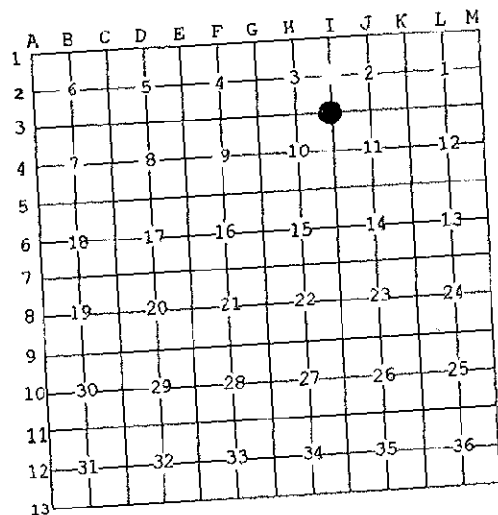

Frederick J. Cutcher, in a field survey on 9/16/97, 19    do hereby state that under requirements of P.A. 74, Michigan P.A. of 1970, the corner points mentioned in lines 1 and 2 above were in conformance with regulations and rules therefore as required in the current manual of survey instructions of the United States Department of the Interior, Bureau of Land Management or by a decree of a Court of Law and/or that the corner points mentioned in lines 3, 4 and 5 above were in conformance with the rules of the Michigan Board of Land Surveyors or by a Decree of a Court of Law; established, re-established, monumented, recovered, found as expressed below:

NOTE: Not more than 2 corners, all in the same town and range, may be recorded on this certificate.

A. Description of original monument and accessories and/or subsequent restoration:  
Original Government Survey by William Brookfield, 1825: B. Walnut 40" S. 10° 15' W. 39 lks.; Lynn 11" S. 70° E. 19 lks.

LCRC (unrecorded, records of Ringenberg) A.J. Hatt, 10/16/73: Set R.R. spike in line w/existing fnc. post at N.W. cor. & conc. post at N.E. cor. of school site; Nail N.E. side 16" Maple S. 47° E. 51.91'; Cen. old fnc. post East 33.0' (N. face of R.R. tie South of old fnc. post 1.0'); Nail S.W. side 8" Maple N. 30° W. 37.73'  
This corner was recovered by J.E. Maxson in August, 1995, and prior to paving of Hillsdale Road a monument box was set by contractor.

B. Description of corner evidence found and/or method applied in restoring or reestablishing corner:  
On 9-16-97 I found a 3/4" iron rod in monument box 1' West of centerline Hillsdale Road.

One witness was found.

C. Description of monument for corner and accessories established to perpetuate locating the position of the corner:  
I set County remonumentation cap on 3/4" iron rod in the Monument Box and is accepted as best available evidence of the position of the original corner.

- 1' West of centerline Hillsdale Road. In line with tree row East.
- Set nail & spotter S. side power pole East 32.58'
- Found nail N. side wood post S. 85° E. 33.00'
- Found nail N.E. side 18" Maple S. 37° E. 51.92'
- N.W. cor. house fcn. (#3031 Prentice School) S. 57° E. 92.70'
- (No accesories West side of road)



Signed by Frederick J. Cutcher  
Surveyor's Michigan License No. Frederick J. Cutcher 24592

Date October 29,  
10/29/97