

ACCEPTED BY THE HILLSDALE COUNTY SURVEY PEER GROUP AS THE OFFICIAL CORNER UNDER MICHIGAN PUBLIC ACT 345 OF 1967 AT A MEETING HELD ON \_\_\_\_\_ AL RINGENBERG, CO. REP.

129165

RECORDED HILLSDALE CO. MICH.

'97 DEC 11 AM 11 50

REMONUMENTATION HILLSDALE COUNTY LAND CORNER RECORDATION CERTIFICATE Filing Requirement of Act 74, Mich. P.A. 1970

*July Wamford*  
R.D. SEEDS

For corners in

HILLSDALE Located in: Corner Code #  
(County)


1. Public Land Survey T 7S R 3W I-5  
T R  
T R  
T R

2. Property Controlling S T R  
in Section S T R

3. Miscellaneous S T R  
Property in Sec. S T R

4. Lot No. \_\_\_\_\_, Recorded Plat

5. Private Claims \_\_\_\_\_

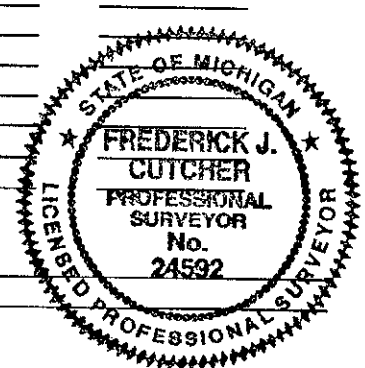

**SURVEY & REMONUMENTATION**  
**FEB 11 1998**  
**SECTION**  
Register of Deeds Stamp & File Number

1	A	B	C	D	E	F	G	H	I	J	K	L	M
2		6		5		4		3		2		1	
3													
4		7		8		9		10		11		12	
5									●				
6		18		17		16		15		14		13	
7													
8		19		20		21		22		23		24	
9													
10		30		29		28		27		26		25	
11													
12		31		32		33		34		35		36	
13													

Frederick J. Cutcher, in a field survey on 12/5, 1997 do hereby state that under requirements of P.A. 74, Michigan P.A. of 1970, the corner points mentioned in lines 1 and 2 above were in conformance with regulations and rules therefore as required in the current manual of survey instructions of the United States Department of the Interior, Bureau of Land Management or by a decree of a Court of Law and/or that the corner points mentioned in lines 3, 4 and 5 above were in conformance with the rules of the Michigan Board of Land Surveyors or by a Decree of a Court of Law; established, re-established, monumented, recovered, found as expressed below:

NOTE: Not more than 2 corners, all in the same town and range, may be recorded on this certificate.

A. Description of original monument and accessories and/or subsequent restoration:  
Original Government Survey by William Brookfield, 1825: Beech 18" N. 77° W. 16 lks.; W. Oak 30" N. 49° 15' E. 42 lks.  
Notes of Ringenberg, no date: 12" Twin Walnut N. 15° W. 102.0'; 24" Elm N. 33° E. 48.9'; 15" stone West 33.0'. Remarks: Established from existing fence line and ties of survey by Geo. Mark dated 1/19/1872.  
Notes of Ringenberg, 11/30/73: R.R. spike; P.K. N.W. side 16" Cherry S. 40° W. 45.21'; Stone West 33'; P.K. Nail S. side pwr. pole S. 80° E. 32.11'.  
Notes of Ringenberg, 5/17/90: R.R. spike; 1'5" rock West 33.1'; Trip. Elm S. 83° W. 34.97'; Elm S. 40° W. 44.67'; pwr. pole S. 74° E. 32.26'.\*

B. Description of corner evidence found and/or method applied in restoring or reestablishing corner:  
\*This corner was recovered by J.E. Maxson in August, 1995, and prior to paving of Hillsdale Road a monument box was set by contractor.  
On 9-16-97 I found a monument box with no iron 2.7' West of centerline Hillsdale Road.  
One reference remained.

C. Description of monument for corner and accessories established to perpetuate locating the position of the corner:  
Triple Elm S. 83° W. 34.97' was only reference that fit monument box. After considerable peer group discussion it was decided to accept this corner as the best available evidence of the position of the original corner.  
On 12-5-97 I set a 1/2"x18" iron bar with County remonumentation cap in center of monument box.

2.7' West of centerline Hillsdale Road & in line with fence to East. Nail & spotter N.W. side 16" W. Cherry S. 37° W. 46.32'; Nail & spotter N. side 14" B. Walnut S. 86° W. 80.60'; Spruce sapling N. 65° W. 47.7'; P.K. & spotter S. side util. pole S. 75° E. 32.65'; P.K. & spotter S. side R.R. tie fence post S. 85° E. 32.00'

Signed by Frederick J. Cutcher Date 12/8/97  
Surveyor's Michigan License No. Frederick J. Cutcher 24592