

ACCEPTED BY THE HILLSDALE COUNTY SURVEY PEER GROUP AS THE OFFICIAL CORNER UNDER MICHIGAN PUBLIC ACT 345 OF 1990 AT A MEETING HELD ON _____ AL RINGENBERG, CO. REC.

RECORDED
HILLSDALE CO. MICH.

REMONUMENTATION

LAND CORNER RECORDATION CERTIFICATE
Filing Requirement of Act 74, Mich. P.A. 1970


'97 NOV 12 AM 9 07

For corners in

HILLSDALE (County)	Located In: <u>ETS</u>	Corner Code #
1. Public Land Survey	T <u>7S</u> R <u>3W</u>	<u>I-6</u>
	T _____ R _____	_____
	T _____ R _____	_____
	T _____ R _____	_____
2. Property Controlling in Section	S _____ T _____ R _____	_____
	S _____ T _____ R _____	_____
3. Miscellaneous Property in Sec.	S _____ T _____ R _____	_____
	S _____ T _____ R _____	_____

Justin VanZandt
S.D. OF NEEDS
SURVEY & REMONUMENTATION
FEB 11 1998
Register of ~~Sections~~ & File Number

4. Lot No. _____ ; Recorded Plat _____
5. Private Claims _____

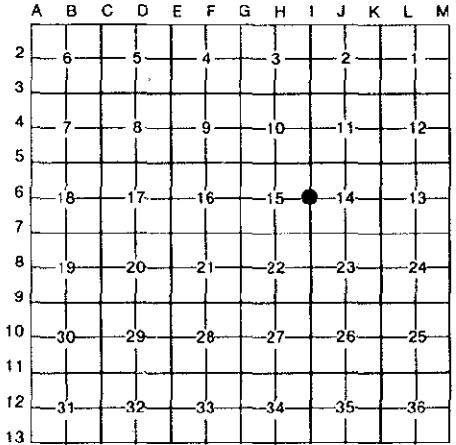

Frederick J. Cutcher

I, Frederick J. Cutcher in a field survey on 11/8, 1997, do hereby certify that under requirements of P.A. 74, Michigan P.A. of 1970, the corner points mentioned in lines 1 and 2 above were in conformance with regulations and rules therefore as required in the current manual of survey instructions of the United States Department of the Interior, Bureau of Land Management or by a decree of a Court of Law and/or that the corner points mentioned in lines 3, 4 and 5 above were in conformance with the rules of the Michigan Board of Land Surveyors or by a Decree of a Court of Law; established, re-established, monumented, re-monumented, recovered, found as expressed below:

NOTE: Not more than 4 corners, all in the same town and range, may be recorded on this certificate.

A. Description of original monument and accessories and/or subsequent restoration:

Original Government Survey by William Brookfield, 1825: Beech 15" S. 75° E. 15½ lks.; W. Oak 30" N. 40° W. 68 lks.

This corner was recovered by J.E. Maxson in August, 1995, and prior to paving of Hillsdale Road a monument box was set by contractor.

B. Description of corner evidence found and/or method applied in restoring or reestablishing corner:

On 9-16-97 I found a monument box with no iron 1.5' West of centerline Hillsdale road and in line with fence East and West.

No witness were found.

C. Description of monument for corner and accessories established to perpetuate locating the position of the corner:

On 11-8-97 I found monument box filled with gravel and asphalt chunks and set 1/2"x18" iron with County remonumentation cap in center of monument box and is accepted as best available evidence of the position of the original corner.

- 1.5' West of centerline Hillsdale Road. In line with fence East and West.
- Fd. P.K. S. side fence end post East 37.26'
- Set mag. nail & spotter N. side R.R. tie fence cor. post West 29.50'
- Set nail & spotter S.W. side pwr. pole S. 32° E. 53.27'
- Set nail & spotter N.W. side 10" Ash S. 38° W. 49.05'

Signed by Frederick J. Cutcher Date 11/10/97

Surveyor's Michigan License No. Frederick J. Cutcher 24592

