



REMONUMENTATION

LAND CORNER RECORDATION CERTIFICATE
Filing Requirement of Act 74, Mich. P.A. 1970

LIBER 3 PAGE 340

025222

RECORDED
HILLSDALE CO. MICH.

NOV 29 AM 9:16

Jeffrey A. Bieszk
REGISTER DEEDS

Register of Deeds Stamp & File Number

For corners in

<u>HILLSDALE</u> (County)	Located In:	Corner Code #
1. Public Land Survey	T <u>8S</u> R <u>2W</u>	<u>G-9</u>
	T _____ R _____	_____
	T _____ R _____	_____
	T _____ R _____	_____
2. Property Controlling in Section	S _____ T _____ R _____	_____
	S _____ T _____ R _____	_____
3. Miscellaneous Property in Sec.	S _____ T _____ R _____	_____
	S _____ T _____ R _____	_____

4. Lot No. _____, Recorded Plat _____
5. Private Claims _____

I, Jeffrey A. Bieszk, in a field survey on 25 Oct., 1999 do hereby state that under requirements of P.A. 74, Michigan P.A. of 1970, the corner points mentioned in lines 1 and 2 above were in conformance with regulations and rules therefore as required in the current manual of survey instructions of the United States Department of the Interior, Bureau of Land Management or by a decree of a Court of Law and/or that the corner points mentioned in lines 3, 4 and 5 above were in conformance with the rules of the Michigan Board of Land Surveyors or by a Decree of a Court of Law; established, re-established, monumented, recovered, found as expressed below:

NOTE: Not more than 2 corners, all in the same town and range, may be recorded on this certificate.

	A	B	C	D	E	F	G	H	I	J	K	L	M
2		6		5		4		3		2		1	
3													
4		7		8		9		10		11		12	
5													
6		18		17		16		15		14		13	
7													
8		19		20		21		22		23		24	
9													
10		30		29		28		27		26		25	
11													
12		31		32		33		34		35		36	
13													

A. Description of original monument and accessories and/or subsequent restoration:

GLO set by Wm. Brookfield. (1825)
Corner is 14" Elm Tree


LCRC, Donald Olmstead L2 - P57 also Survey L1-P943
Iron pipe
Stop sign NW 47.1 ft.
Road sign NE 36.7 ft.
Stop sign SE 46.98 ft.
Top center end 18" Road Culvert SW 48.2 ft.

B. Description of corner evidence found and/or method applied in restoring or reestablishing corner:

Found iron as in Olmstead LCRC, which he set from GLO distance from H-9. Dug and found no other evidence, accepted as the best available evidence of the position of the original corner.

C. Description of monument for corner and accessories established to perpetuate locating the position of the corner:

Set 5/8" x 36" iron w/cap in Monument Box		
Stop sign	S 05 E	46.91 ft.
Stop sign	N 35 W	47.67 ft.
Nail w/tag fence post	S 75 W	53.98 ft.
Phone riser	N 40 E	35.55 ft.

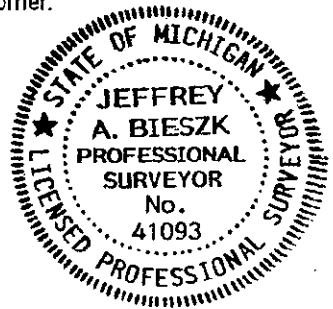

Signed by *Jeffrey A. Bieszk*
Surveyor's Michigan License No. 41093

Date 24 November 1999