



REMONUMENTATION

LAND CORNER RECORDATION CERTIFICATE
Filing Requirement of Act 74, Mich. P.A. 1970

LIBER 3 PAGE 343

For corners in

HILLSDALE

(County)

Located In:

Corner Code #

1. Public Land Survey	T <u>8S</u> R <u>2W</u>	J-9
	T _____ R _____	_____
	T _____ R _____	_____
	T _____ R _____	_____
2. Property Controlling in Section	S _____ T _____ R _____	_____
	S _____ T _____ R _____	_____
3. Miscellaneous Property in Sec.	S _____ T _____ R _____	_____
	S _____ T _____ R _____	_____

025225

RECORDED
HILLSDALE CO. MICH.

09 NOV 20 AM 9:17

Jeffrey A. Bieszk
REG. LICENSED

Register of Deeds Stamp & File Number

4. Lot No. _____, Recorded Plat _____
5. Private Claims _____

I, Jeffrey A. Bieszk, in a field survey on 25 Oct., 1999 do hereby state that under requirements of P.A. 74, Michigan P.A. of 1970, the corner points mentioned in lines 1 and 2 above were in conformance with regulations and rules therefore as required in the current manual of survey instructions of the United States Department of the Interior, Bureau of Land Management or by a decree of a Court of Law and /or that the corner points mentioned in lines 3, 4 and 5 above were in conformance with the rules of the Michigan Board of Land Surveyors or by a Decree of a Court of Law; established, re-established, monumented, recovered, found as expressed below:

NOTE: Not more than 2 corners, all in the same town and range, may be recorded on this certificate.

	A	B	C	D	E	F	G	H	I	J	K	L	M
1													
2		6		5		4		3		2		1	
3													
4		7		8		9		10		11		12	
5													
6		16		17		16		15		14		13	
7													
8		19		20		21		22		23		24	
9										●			
10		30		29		28		27		26		25	
11													
12		31		32		33		34		35		36	
13													

A. Description of original monument and accessories and/or subsequent restoration:


GLO set by Wm. Brookfield. (1825)	LCRC Alan Ringenberg L2-P11	Survey Olmstead L1-P943
6" W. Oak S61E 11 lks	Found Nail	Stop Sign SE 46.98 ft.
4" W. Oak S11.5 E 3 lks.	PK in 10" Tree N10W 102.67 ft.	Phone Box NW 44.4 ft.
	10" Double Tree N25E 65.19 ft.	Iron Fence post NE 41.2 ft.
	10" Maple S15W 51.04 ft.	Power Pole SW 54.3 ft.

B. Description of corner evidence found and/or method applied in restoring or reestablishing corner:

Found R.R. Spike same as witnesses from Ringenberg LCRC and Olmstead's survey. Corner is in the centerline of Camden Road and occupation North and South. Dug and found no other evidence and accepted as the best available evidence of the position of the original corner.

C. Description of monument for corner and accessories established to perpetuate locating the position of the corner:

Set 5/8" x 36" iron w/cap in Monument Box		
Nail w/tag 6' Maple	S 05 W	34.44 ft.
Nail w/tag 12" Locust	S 35 W	52.37 ft.
Nail w/tag 10' Hickory	N 10 E	65.40 ft.
Nail w/tag 6" Maple	N 45 W	48.35 ft.

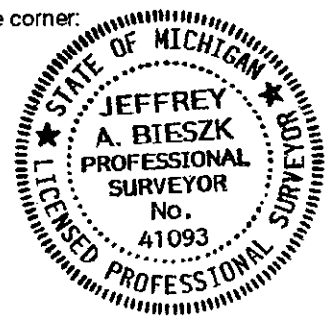

Signed by [Signature]
Surveyor's Michigan License No. 41093

Date 24 NOVEMBER 1999