

REMONUMENTATION

LIBER 3 PAGE 345

LAND CORNER RECORDATION CERTIFICATE
Filing Requirement of Act 74, Mich. P.A. 1970

025227

RECORDED
HILLSDALE CO. MICH.

NOV 29 AM 9:17

[Signature]
REGISTER OFFICE

Register of Deeds Stamp & File Number

For corners in

HILLSDALE

(County)

Located In:

Corner Code #

1. Public Land Survey

T 8 S R 2 W L-9
T R
T R
T R

2. Property Controlling in Section

S T R
S T R
S T R

3. Miscellaneous Property in Sec.

S T R

4. Lot No. _____, Recorded Plat _____

5. Private Claims _____

I, Jeffrey A. Bieszka, in a field survey on 25 Oct., 1999 do hereby state that under requirements of P.A. 74, Michigan P.A. of 1970, the corner points mentioned in lines 1 and 2 above were in conformance with regulations and rules therefore as required in the current manual of survey instructions of the United States Department of the Interior, Bureau of Land Management or by a decree of a Court of Law and/or that the corner points mentioned in lines 3, 4 and 5 above were in conformance with the rules of the Michigan Board of Land Surveyors or by a Decree of a Court of Law; established, re-established, monumented, recovered, found as expressed below:

NOTE: Not more than 2 corners, all in the same town and range, may be recorded on this certificate.

	A	B	C	D	E	F	G	H	I	J	K	L	M
1													
2	6	5	4	3	2	1							
3													
4	7	8	9	10	11	12							
5													
6	18	17	16	15	14	13							
7													
8	19	20	21	22	23	24							
9													
10	30	29	28	27	26	25							
11													
12	31	32	33	34	35	36							
13													

A. Description of original monument and accessories and/or subsequent restoration:


GLO set by Wm. Brookfield. (1825)
13" W. Ash Corner Tree

B. Description of corner evidence found and/or method applied in restoring or reestablishing corner:

Did not find any iron. Took proportionate measurement from K-9 to M-9, point landed centerline of Camden Road. There fit occupation South being a field line. Dug and found nothing. Set corner at proportionate distance and accepted as the best available evidence of the position of the original corner.

C. Description of monument for corner and accessories established to perpetuate locating the position of the corner:

Set 5/8" x 36" iron w/cap in Monument Box		
Set witness iron edge pavement	N 70 E	20.00 ft.
Set witness iron edge pavement	N 75 W	30.00 ft.
Fence post	South	24.40 ft.
Nail w/tag N. side 20" Maple	S 70 W	151.91 ft.

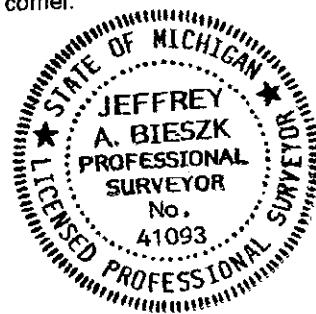

Signed by [Signature] _____
Surveyor's Michigan License No. 41093

Date 24 NOVEMBER 1999